

MISSISSIPPI DEPARTMENT OF NATURAL RESOURCES

Bureau of Land and Water Resources

Southport Mall

P.O. Box 10631

Jackson, Mississippi 39209

WATER WELL DRILLERS LOG

Harrison  
K278


3/1 1982 Lyman Well Co. Harrison  
date well completed firm name county well located

LANDOWNER: <u>J. Michael</u> <u>Const. Gpt. Ms.</u>	description of formations encountered	from	to
(mailing address)	<u>Sand &amp; Gravel</u>	<u>0</u>	<u>100</u>
WELL LOCATION: sec. <u>9</u> T <u>7</u> N R <u>11 E</u> <u>Q2</u> miles <u>SW</u> of <u>Gpt.</u> (distance) (direction) (nearest town)	<u>Bumbo Clay</u>	<u>100</u>	<u>160</u>
WELL PURPOSE: <u>Industrial</u> (home, irrigation, municipal, industrial)	<u>Blue Clay</u>	<u>160</u>	<u>196</u>
WELL COMPLETION DATA:	<u>Good Sand</u>	<u>160</u>	<u>196</u>
(1) diameter (inches) <u>2"</u>			
(2) total depth (feet) <u>196</u>			
(3) static water level (feet) <u>5'</u> <u>below</u> top of ground. <u>above</u>			
(4) casing <u>PVC</u> , <u>186'</u> (material) (depth) <u>2"</u> (size) If telescope see back.			
(5) screen <u>10'</u> , <u>196'</u> (length) (depth to top)			
(6) pump <u>1</u> , <u>20</u> (HP) (yield gpm) <u>Elect.</u> (type power)			
(7) electric log <u>NO</u> (yes or no)			
(8) how well bottom plugged <u>Save Shark</u> (organization running log)			
DRILLERS REMARKS:			

DEPT. OF NATURAL RESOURCES  
BUREAU OF LAND AND WATER RESOURCES

If well telescopes please sketch and show depths.

GROUND LEVEL

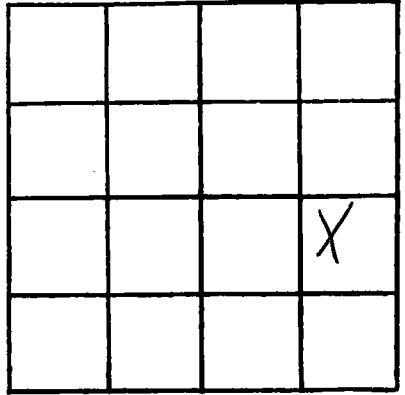

SECTION 19

Please indicate well location X.

ADDITIONAL INFORMATION

If more than one screen, show locations of each on sketch.