

MISSISSIPPI DEPARTMENT OF NATURAL RESOURCES

Bureau of Land and Water Resources

Southport Mall

P.O. Box 10631

Jackson, Mississippi 39209

WATER WELL DRILLERS LOG

Harrison
K279

6-21 1982 Broden Pump & Well Harrison
date well completed firm name county well located

LANDOWNER: TERESA RENEER
Rt. 1 - Thompson Rd.
Long Beach Ms. 39560
(mailing address)

WELL LOCATION:
sec. 34 T 7 S R 12 E
3 miles NW of Long Beach
(distance) (direction) (nearest town)

WELL PURPOSE: Home
(home, irrigation, municipal, industrial)

WELL COMPLETION DATA:

- (1) diameter (inches) 2"
- (2) total depth (feet) 420
- (3) static water level (feet) 30 ^{below} _{above} top of ground.
- (4) casing PVC 410
(material) (depth)
2"
(size) if telescope see back.
- (5) screen 10 410
(length) (depth to top)
2" PVC 1008
(size) (material)
- (6) pump 1 10
(HP) (yield gpm)
220 V 1P
(type power)
- (7) electric log No
(yes or no)
(organization running log)
- (8) how well bottom plugged
2" PVC Sand Shank

description of formations encountered	from	to
<u>Clay</u>	<u>0</u>	<u>10</u>
<u>Sand & Clay</u>	<u>0</u>	<u>90</u>
<u>Grey Clay</u>	<u>90</u>	<u>140</u>
<u>Sand</u>	<u>140</u>	<u>150</u>
<u>Blue Clay</u>	<u>150</u>	<u>160</u>
<u>Sand</u>	<u>160</u>	<u>170</u>
<u>Clay - Blue</u>	<u>170</u>	<u>220</u>
<u>Sand</u>	<u>220</u>	<u>230</u>
<u>Blue Clay</u>	<u>230</u>	<u>340</u>
<u>Sand</u>	<u>340</u>	<u>250</u>
<u>Blue Clay</u>	<u>350</u>	<u>390</u>
<u>Grey Sand</u>	<u>390</u>	<u>420</u>

DEPT. OF NATURAL RESOURCES
BUREAU OF LAND & WATER RESOURCES


JUN 28 1982

RECEIVED

DRILLERS REMARKS:

If well telescopes please sketch and show depths.

GROUND LEVEL

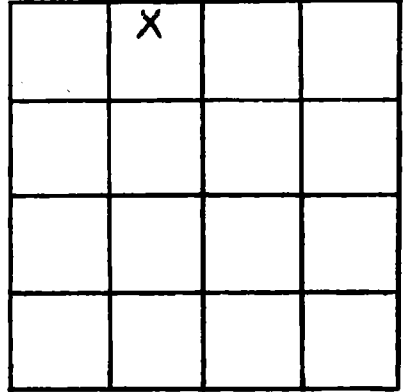

SECTION 34

Please indicate well location X.

ADDITIONAL INFORMATION

If more than one screen, show locations of each on sketch.