

MISSISSIPPI DEPARTMENT OF NATURAL RESOURCES

Bureau of Land and Water Resources

Southport Mall

P.O. Box 10631

Jackson, Mississippi 39209

WATER WELL DRILLERS LOG

Harrison
K280

Aug 19 1982 Duncan Well Drilling Harrison
date well completed firm name county well located

LANDOWNER: Jack Collins
200 E. Railroad
Long Beach, Ms.
(mailing address)

description of formations encountered	from	to
<u>Top Sand</u>	<u>0</u>	<u>15</u>
<u>Blue Clay</u>	<u>15</u>	<u>45</u>
<u>Coarse Sand</u>	<u>45</u>	<u>60</u>

WELL LOCATION:
sec 34 T 2 N R 12 E
3 miles N.W. of Long Beach
(distance) (direction) (nearest town)

WELL PURPOSE:
(home, irrigation, municipal, industrial)

WELL COMPLETION DATA:

(1) diameter (inches) 2"

(2) total depth (feet) 60'

(3) static water level (feet) 10' below above top of ground.

(4) casing PVC, 50'
(material) (depth)
(size) if telescope see back.

(5) screen 10', 50'
(length) (depth to top)
(size) (material)

(6) pump (HP) (yield gpm)
electric
(type power)

(7) electric log (yes or no)
(organization running log)

(8) how well bottom plugged Sand
shale

DEPT. OF NATURAL RESOURCES
BUREAU OF LAND & WATER RESOURCES


AUG 30 1982

RECEIVED

DRILLERS REMARKS:
Drillers has own pump

If well telescopes please sketch and show depths.

GROUND LEVEL

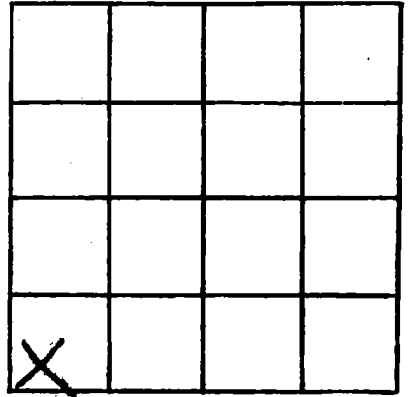

SECTION 34

Please indicate well location X.

ADDITIONAL INFORMATION

If more than one screen,
show locations of each on sketch.