

MISSISSIPPI DEPARTMENT OF NATURAL RESOURCES

Bureau of Land and Water Resources

Southport Mall

P.O. Box 10631

Jackson, Mississippi 39209

WATER WELL DRILLERS LOG

Harrison  
K281

May 18 1982 Duncan Well Drilling Harrison  
date well completed firm name county well located

LANDOWNER Lloyd Andrews  
Rt. 2 Box 329-D  
Long Beach Ms. 39560  
(mailing address)

description of formations encountered	from	to
<u>sand</u>	<u>0</u>	<u>25</u>
<u>clay</u>	<u>25</u>	<u>120</u>
<u>sand</u>	<u>120</u>	<u>140</u>
<u>blue clay</u>	<u>140</u>	<u>450</u>
<u>fine sand</u>	<u>450</u>	<u>490</u>
<u>coarse sand</u>	<u>490</u>	<u>525</u>

WELL LOCATION:  
sec. 34 T. 8 N. R. 12 E.  
3 miles NW of Long Beach  
(distance) (direction) (nearest town)

WELL PURPOSE: Home  
(home, irrigation, municipal, industrial)

WELL COMPLETION DATA:

(1) diameter (inches) 2"

(2) total depth (feet) 525'

(3) static water level (feet) 8' below above top of ground.

(4) casing PVC 515'  
(material) (depth)  
(size) if telescope see back.

(5) screen 10' 515'  
(length) (depth to top)  
2" PVC  
(size) (material)

(6) pump 1 10'  
(HP) (yield gpm)  
electric  
(type power)

(7) electric log                       
(yes or no)

                      
(organization running log)

(8) how well bottom plugged Lloyd  
Andrews

DRILLERS REMARKS:                     


DEPT. OF NATURAL RESOURCES  
BUREAU OF LAND AND WATER RESOURCES

AUG 27 1982

RECEIVED

If well telescopes please sketch and show depths.

GROUND LEVEL

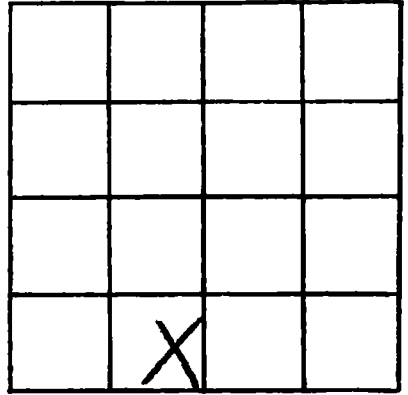

SECTION 34

Please indicate well location X.

ADDITIONAL INFORMATION

If more than one screen, show locations of each on sketch.