

MISSISSIPPI DEPARTMENT OF NATURAL RESOURCES

Bureau of Land and Water Resources

Southport Mall

P.O. Box 10631

Jackson, Mississippi 39209

WATER WELL DRILLERS LOG

Harrison
K282

May 21, 1982 Duncan Well Drilling Harrison
 date well completed firm name county well located

LANDOWNER: George Wright
 803 Sweetgum Dr.
 Gulfport, Ms. 39501
 (mailing address)

description of formations encountered	from	to
Sand	0	25
Clay	25	120
Sand	120	140
Blue Clay	140	450
fine Sand	450	490
Coarse Sand	490	525

WELL LOCATION:
 sec. 34 T. 79 N. R. 12 E
 3 miles NW of Long Beach
 (distance) (direction) (nearest town)

WELL PURPOSE: Home
 (home, irrigation, municipal, industrial)

WELL COMPLETION DATA:
 (1) diameter (inches) 2"
 (2) total depth (feet) 525'
 (3) static water level (feet) 8' below top of ground.
 (4) casing PVC, 515' (material) (depth)
 (size) if telescope see back.
 (5) screen 10' (length) 515' (depth to top)
 2" (size) PVC (material)
 (6) pump 1 (HP) 10' (yield gpm)
 electric (type power)
 (7) electric log (yes or no)

(organization running log)
 (8) how well bottom plugged Sand
 Chuck

DRILLERS REMARKS:


DEPT. OF NATURAL RESOURCES
 BUREAU OF LAND & WATER RESOURCES

AUG 27 1982

RECEIVED

If well telescopes please sketch and show depths.

GROUND LEVEL

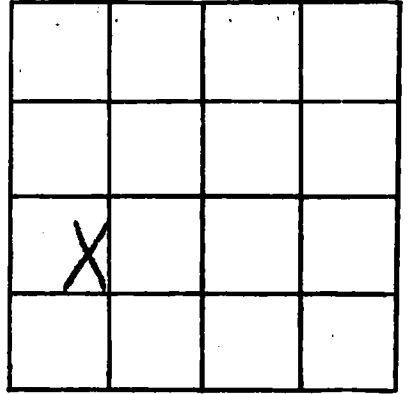

SECTION 34

Please indicate well location X.

ADDITIONAL INFORMATION

If more than one screen, show locations of each on sketch.