

MISSISSIPPI DEPARTMENT OF NATURAL RESOURCES

Bureau of Land and Water Resources

Southport Mall

P.O. Box 10631

Jackson, Mississippi 39209

WATER WELL DRILLERS LOG

<i>Amson</i>
<i>K283</i>

*June 21* 19*82* *Duncan Well Drilling* *Narrison*  
 date well completed firm name county well located

LANDOWNER: *Floyd Coats*  
*110 East Street*  
*Long Beach Ms. 39560*  
 (mailing address)

description of formations encountered	from	to
<i>Mud &amp; Sand</i>	<i>0</i>	<i>25</i>
<i>Blue Clay</i>	<i>25</i>	<i>60</i>
<i>Clay &amp; Sand</i>	<i>60</i>	<i>80</i>
<i>Course Sand</i>	<i>80</i>	<i>100</i>

WELL LOCATION:  
 sec. *34 T 78 N R 12 E*  
*3* miles *N.W.* of *Long Beach*  
 (distance) (direction) (nearest town)

WELL PURPOSE: *None*  
 (home, irrigation, municipal, industrial)

WELL COMPLETION DATA:

(1) diameter (inches) *2"*

(2) total depth (feet) *100 ft.*

(3) static water level (feet) *10'* below top of ground.

(4) casing *PVC* *90*  
 (material) (depth)  
 (size) if telescope see back.

(5) screen *10'* *90'*  
 (length) (depth to top)  
*2"* *PVC*  
 (size) (material)

(6) pump \_\_\_\_\_ (HP) \_\_\_\_\_ (yield gpm)  
 (type power)

(7) electric log \_\_\_\_\_ (yes or no)  
 (organization running log)

(8) how well bottom plugged *Sand*  
*Shank*

DRILLERS REMARKS: *Owner has his own pump*


DEPT. OF NATURAL RESOURCES  
 BUREAU OF LAND & WATER RESOURCES

AUG 27 1982

RECEIVED

If well telescopes please sketch and show depths.

GROUND LEVEL

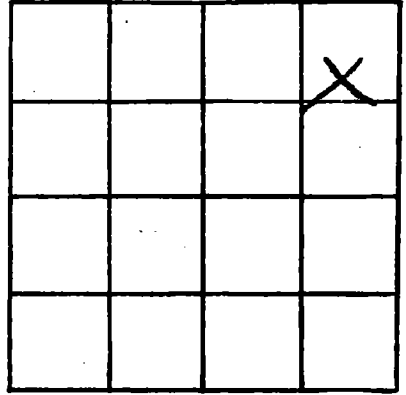

SECTION 34

Please indicate well location X.

ADDITIONAL INFORMATION

If more than one screen, show locations of each on sketch.