

Harrison
K284

MISSISSIPPI DEPARTMENT OF NATURAL RESOURCES
Bureau of Land and Water Resources
Southport Mall
P.O. Box 10631
Jackson, Mississippi 39209
WATER WELL DRILLERS LOG

June 16 1982 Duncom Well Drilling Harrison
date well completed firm name county well located

LANDOWNER: Jerry Fitzpatrick
317 E. 2nd Street
Pass Christian
(mailing address)

description of formations encountered	from	to
<u>mud & sand</u>	<u>0</u>	<u>25</u>
<u>blue clay</u>	<u>25</u>	<u>60</u>
<u>clay sand</u>	<u>60</u>	<u>80</u>
<u>course sand</u>	<u>80</u>	<u>100</u>

WELL LOCATION:
sec. 12 T. 2 N. R. 12 E.
3 miles NE of Pass
(distance) (direction) (nearest town)

WELL PURPOSE:
(home, irrigation, municipal, industrial)

WELL COMPLETION DATA:

(1) diameter (inches) 2"

(2) total depth (feet) 100'

(3) static water level (feet) 10' below above top of ground.

(4) casing PVC, 90'
(material) (depth)
 If telescope see back.
(size)

(5) screen 10', 90'
(length) (depth to top)
2", PVC
(size) (material)

(6) pump _____ (HP) _____ (yield gpm)
(type power) _____

(7) electric log _____ (yes or no)
(organization running log) _____

(8) how well bottom plugged sand
shank

DRILLERS REMARKS: _____


DEPT. OF NATURAL RESOURCES
BUREAU OF LAND & WATER RESOURCES

AUG 27 1982

RECEIVED

If well telescopes please sketch and show depths.

GROUND LEVEL

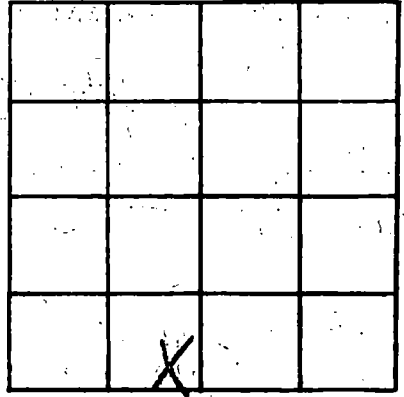

SECTION 1B

Please indicate well location X.

ADDITIONAL INFORMATION

If more than one screen, show locations of each on sketch.