

*Harrison*  
*K291*

MISSISSIPPI DEPARTMENT OF NATURAL RESOURCES  
 Bureau of Land and Water Resources  
 Southport Mall  
 P.O. Box 10631  
 Jackson, Mississippi 39209  
**WATER WELL DRILLERS LOG**

10-28- 1982 Wood Well Drg. Harrison  
 date well completed firm name county well located

LANDOWNER: Lucy Violet  
Rt. 2, Box 799  
Pass Christian, ms.  
 (mailing address)

description of formations encountered	from	to
	<u>Clay</u>	<u>0</u>
<u>Sandy clay</u>	<u>46</u>	<u>87</u>
<u>Clay w/ sh. pebbles</u>	<u>87</u>	<u>175</u>

WELL LOCATION:  
 sec 13 T 7 N R 12 E  
5 miles N/E of Delisle  
 (distance) (direction) (nearest town)

WELL PURPOSE: None  
 (home, irrigation, municipal, industrial)


- WELL COMPLETION DATA:
- (1) diameter (inches) 2"
  - (2) total depth (feet) 500
  - (3) static water level (feet) 94 <sup>below</sup> above top of ground.
  - (4) casing PVC, 490  
 (material) (depth)  
 (size) If telescope see back.
  - (5) screen 10', -  
 (length) (depth to top)  
2", PVC  
 (size) (material)
  - (6) pump Owner  
 (HP) (yield gpm)  
 (type power)
  - (7) electric log NO  
 (yes or no)  
N/A  
 (organization running log)
  - (8) how well bottom plugged BWU

DRILLERS REMARKS: N/A

RECEIVED  
 DEC 20 1982  
 DEPT. OF NATURAL RESOURCES  
 BUREAU OF LAND RESOURCES

If well telescopes please sketch and show depths.

GROUND LEVEL

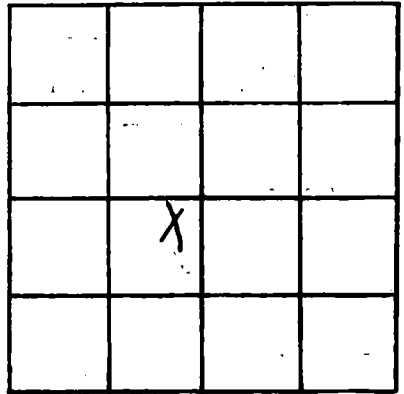

SECTION 13

Please indicate well location X.

ADDITIONAL INFORMATION

If more than one screen, show locations of each on sketch.