

MISSISSIPPI DEPARTMENT OF NATURAL RESOURCES

Bureau of Land and Water Resources

Southport Mall

P.O. Box 10631

Jackson, Mississippi 39209

WATER WELL DRILLERS LOG

Hansin
K293

Dec. 7 1982
date well completed

82 Duncan Well Drilling
firm name

Harrison
county well located

LANDOWNER: Robert Carco
P.O. 254
Pass Christian
(mailing address)

description of formations encountered

from to

<u>sand</u>	<u>0</u>	<u>90</u>
<u>mixed sand & clay</u>	<u>90</u>	<u>110</u>
<u>fine sand</u>	<u>110</u>	<u>125</u>
<u>blue clay</u>	<u>125</u>	<u>140</u>
<u>course sand</u>	<u>140</u>	<u>160</u>

WELL LOCATION:
sec. 12 T. 8 N. R. 12 E.
4 miles NE of Pass Christian
(distance) (direction) (nearest town)

WELL PURPOSE: Home
(home, irrigation, municipal, industrial)

WELL COMPLETION DATA:

- (1) diameter (inches) 2"
- (2) total depth (feet) 160 ft.
- (3) static water level (feet) 92' below above top of ground.
- (4) casing PVC 150'
(material) (depth)
- (size) if telescope see back.
- (5) screen 10' 150'
(length) (depth to top)
- (size) (material) 2" PVC
- (6) pump 1 10
(HP) (yield gpm)
- (type power) electric
- (7) electric log _____
(yes or no)
- (organization running log) _____
- (8) how well bottom plugged sand

DRILLERS REMARKS:


DEPT. OF NATURAL RESOURCES
BUREAU OF LAND & WATER RESOURCES

JAN 21 1983

RECEIVED

If well telescopes please sketch and show depths.

GROUND LEVEL

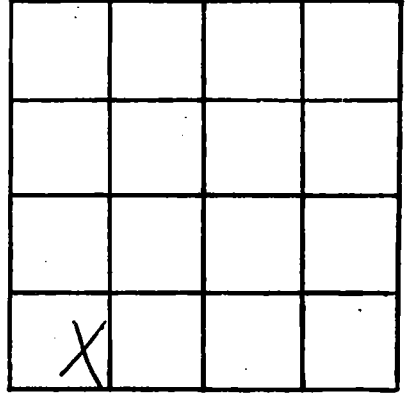

SECTION 12

Please indicate well location X.

ADDITIONAL INFORMATION

If more than one screen, show locations of each on sketch.