

MISSISSIPPI DEPARTMENT OF NATURAL RESOURCES

Bureau of Land and Water Resources

Southport Mall

P.O. Box 10631

Jackson, Mississippi 39209

WATER WELL DRILLERS LOG

Harrison
K299

Feb. 15 1983 Duncan Well Drilling Harrison
date well completed firm name county well located

LANDOWNER: Zeneth Builders
Landen Road
Shufport, Ms. 39523
(milling address)

Description of formations encountered	from	to
<u>Clay</u>	<u>0</u>	<u>15</u>
<u>fine sand</u>	<u>15</u>	<u>60</u>
<u>Blue Clay</u>	<u>60</u>	<u>203</u>
<u>fine sand</u>	<u>203</u>	<u>235</u>
<u>cluser sand</u>	<u>235</u>	<u>252</u>

WELL LOCATION:
sec 14 T 7 N R 12 E
5 miles N.W of Shufport
(distance) (direction) (nearest town)

WELL PURPOSE: Home
(home, irrigation, municipal, industrial)

WELL COMPLETION DATA:

(1) diameter (inches) 2"

(2) total depth (feet) 252'

(3) static water level (feet) 30' below above top of ground.

(4) casing pvc, 242'
(material) (depth)
(size) if telescope see back.

(5) screen 10', 242'
(length) (depth to top)
2", pvc
(size) (material)

(6) pump 1, 10
(HP) (yield gpm)
electric
(type power)

(7) electric log _____
(yes or no)

(organization running log)

(8) how well bottom plugged, sand
shark

DRILLERS REMARKS:


DEPT. OF NATURAL RESOURCES
BUREAU OF LAND & WATER RESOURCES

AUG 18 1983

RECEIVED

If well telescopes please sketch and show depths.

GROUND LEVEL

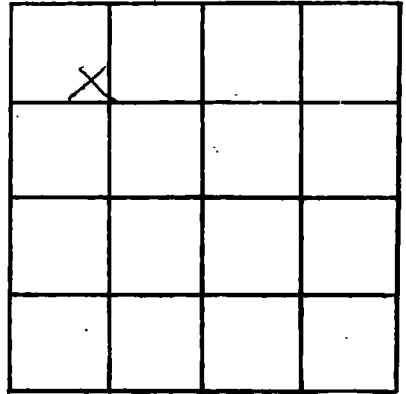

SECTION 14

Please indicate well location X.

ADDITIONAL INFORMATION

Lined area for additional information.

If more than one screen, show locations of each on sketch.