

MISSISSIPPI DEPARTMENT OF NATURAL RESOURCES

Bureau of Land and Water Resources

Southport Mall

P.O. Box 10631

Jackson, Mississippi 39209

WATER WELL DRILLERS LOG

CODED

HARRISON
K 306

8/10 1984 *Braden Pump & Well Serv., Inc.* *Harrison*
date well completed firm name county well located

LANDOWNER: *Merna Negretto*
Eddy Rd. - Delisle
Pass Christian, MS
(mailing address) *39571*

description of formations encountered	from	to
<i>Clay</i>	<i>0</i>	<i>20</i>
<i>Sand</i>	<i>20</i>	<i>110</i>
<i>Clay</i>	<i>110</i>	<i>120</i>

WELL LOCATION:
sec. *25* T. *7* S. R. *13* E.
2 miles *North* of *Delisle*
(distance) (direction) (nearest town)

WELL PURPOSE: *Home*
(home, irrigation, municipal, industrial)

WELL COMPLETION DATA:

(1) diameter (inches) *4"*

(2) total depth (feet) *120*

(3) static water level (feet) *44* below top of ground.

(4) casing *PVC*, *90ft*
(material) (depth)
4"
(size) If telescope see back.

(5) screen *10ft*, *90ft*
(length) (depth to top)
2", *PVC underbar*
(size) (material)

(6) pump *1* *15*
(HP) (yield gpm)
230 volt
(type power)

(7) electric log *no*
(yes or no)

CODED

(organization running log)

(8) how well bottom plugged *PVC*
Parishark

DRILLERS REMARKS: *20 ft*
tailpipe


DEPT. OF NATURAL RESOURCES
BUREAU OF LAND & WATER RESOURCES

AUG 16 1984

RECEIVED

If well telescopes please sketch and show depths.

GROUND LEVEL

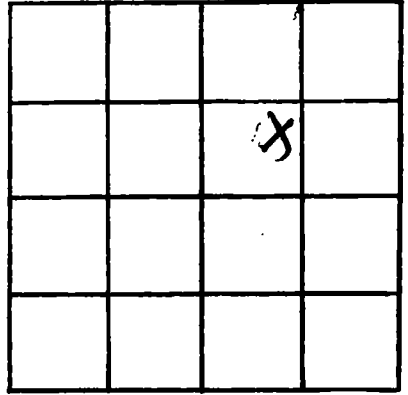

SECTION 25

Please indicate well location X.

ADDITIONAL INFORMATION

If more than one screen, show locations of each on sketch.