

MISSISSIPPI DEPARTMENT OF NATURAL RESOURCES

Bureau of Land and Water Resources

Southport Mall

P.O. Box 10631

Jackson, Mississippi 39209

WATER WELL DRILLERS LOG

CODED

HARRISON
K308
5/16/84

5/16/84 19 Lyman Well Co. Harrison
date well completed firm name county well located

LANDOWNER: Steve DeDro
Robinson Rd.
Subport, MS 39503
(mailing address)

description of fomations encountered	from	to
<u>Red Clay</u>	<u>0</u>	<u>80</u>
<u>Blue Clay</u>	<u>80</u>	<u>155</u>
<u>Good Sand & Gravel</u>	<u>153</u>	<u>195</u>

WELL LOCATION:
sec. 1 - T. 7 N. R. 12 E.
10 miles N/W of Sub.
(distance) (direction) (nearest town)

WELL PURPOSE: Private
(home, irrigation, municipal, industrial)

CODED

WELL COMPLETION DATA:

(1) diameter (inches) 2"

(2) total depth (feet) 194'

(3) static water level (feet) 30 (below/above top of ground)

(4) casing PVC, 184'
(material) (depth)
2' If telescope see back.
(size)

(5) screen 10', 184'
(length) (depth to top)
2", PVC
(size) (material)

(6) pump 1, 12
(HP) (yield gpm)
electric
(type power)

(7) electric log No
(yes or no)
No
(organization running log)

(8) how well bottom plugged sand
shark

DEPT. OF NATURAL RESOURCES
BUREAU OF LAND & WATER RESOURCES


SEP - 5 1984

RECEIVED

DRILLERS REMARKS:

If well telescopes please sketch and show depths.

GROUND LEVEL

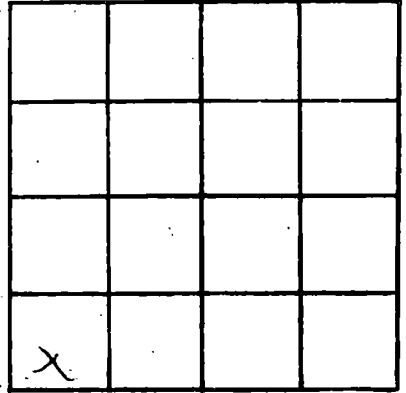

SECTION 1

Please indicate well location X.

ADDITIONAL INFORMATION

If more than one screen,
show locations of each on sketch.