

MISSISSIPPI DEPARTMENT OF NATURAL RESOURCES
Bureau of Land and Water Resources
 Southport Mall
 P.O. Box 10631
 Jackson, Mississippi 39209
WATER WELL DRILLERS LOG

CODED

Harrison
 K 316
 12/3/84

12/3/84 19 Lyman Well Co. Harrison
 date well completed firm name county well located

LANDOWNER	Description of formations encountered	from	to
Lusan Bobinger	blue clay	0	340
P.O. Drawer C	clay & sand	340	360
Gulfport Md 39501	coarse sand	360	385
(milling address)	COARSE SAND	385	395

CODED


WELL LOCATION:

sec. 21 T. 7 N. R. 12 E.
 5 miles South of Long Beach
 (distance) (direction) (nearest town)

WELL PURPOSE: same
 (home, irrigation, municipal, industrial)

WELL COMPLETION DATA:

- (1) diameter (inches) 2"
- (2) total depth (feet) 395'
- (3) static water level (feet) 20' below above top of ground
- (4) casing PVC 385'
 (material) (depth)
2"
 (size) if telescope see back.
- (5) screen 10' 385'
 (length) (depth to top)
2" PVC
 (size) (material)
- (6) pump 1 12
 (HP) (yield gpm)
electro
 (type power)

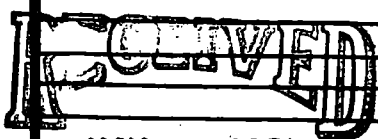

MAY 24 1985

Department of Natural Resources
 Bureau of Land & Water Resources


(7) electric log No
 (yes or no)
No
 (organization running log)

(8) how well bottom plugged sand
Shark

DRILLERS REMARKS:

If well telescopes please sketch and show depths.

GROUND LEVEL

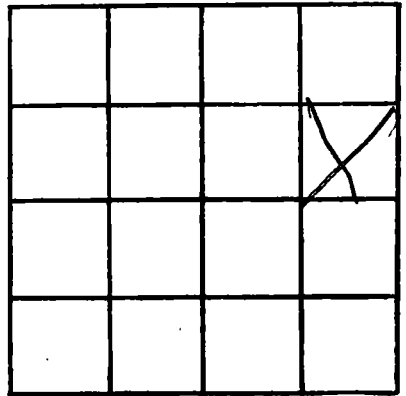

SECTION 21

Please indicate well location X.

ADDITIONAL INFORMATION

If more than one screen, show locations of each on sketch.