

MISSISSIPPI DEPARTMENT OF NATURAL RESOURCES

Bureau of Land and Water Resources

Southport Mall

P.O. Box 10631

Jackson, Mississippi 39209 **CODED**

WATER WELL DRILLERS LOG

Harrison  
K317  
12-22-84

12-22 1984 Mc Hill Pumping Harrison  
date well completed firm name county well located

LANDOWNER: Ed Adams  
Box 864  
Long Beach, Ms.  
(mailing address)

WELL LOCATION:  
sec. 34 T. 7 N R. 12 E  
5 miles NW of LIB  
(distance) (direction) (nearest town)

WELL PURPOSE:  
(home, irrigation, municipal, industrial)

- WELL COMPLETION DATA:
- (1) diameter (inches) 2'
  - (2) total depth (feet) 415
  - (3) static water level (feet) 40 below above top of ground.
  - (4) casing Pvc Sch. 40 405  
(material) (depth)  
         if telescope see back.  
(size)
  - (5) screen 10' 405  
(length) (depth to top)  
2" Sch. 80 6 slot  
(size) (material)
  - (6) pump \_\_\_\_\_ (HP) \_\_\_\_\_ (yield gpm)  
         (type power)
  - (7) electric log \_\_\_\_\_ (yes or no)  
         (organization running log)
  - (8) how well bottom plugged Sand  
Shard

description of formations encountered	from	to
<u>Sand/Mud</u>	<u>0</u>	<u>20</u>
<u>Mud</u> <b>CODED</b>	<u>20</u>	<u>40</u>
<u>Mud</u>	<u>40</u>	<u>60</u>
<u>Sand/Mud</u>	<u>60</u>	<u>80</u>
<u>Mud</u>	<u>80</u>	<u>100</u>
<u>Mud</u>	<u>100</u>	<u>120</u>
<u>Mud</u>	<u>120</u>	<u>140</u>
<u>Mud</u>	<u>140</u>	<u>160</u>
<u>Mud</u>	<u>160</u>	<u>180</u>
<u>Mud/Sand</u>	<u>180</u>	<u>200</u>
<u>Mud</u>	<u>200</u>	<u>220</u>
<u>Mud</u>	<u>220</u>	<u>240</u>
<u>Mud</u>	<u>240</u>	<u>260</u>
<u>Mud</u>	<u>260</u>	<u>280</u>
<u>Mud</u>	<u>280</u>	<u>300</u>
<u>Mud</u>	<u>300</u>	<u>320</u>
<u>Mud</u>	<u>320</u>	<u>340</u>
<u>Mud</u>	<u>340</u>	<u>360</u>
<u>Mud</u>	<u>360</u>	<u>380</u>
<u>Sand</u>	<u>380</u>	<u>400</u>
<u>Sand</u>	<u>400</u>	<u>415</u>


**RECEIVED**  
MAY 31 1985

Department of Natural Resources  
Bureau of Land & Water Resources

DRILLERS REMARKS: \_\_\_\_\_

If well telescopes please sketch and show depths.

GROUND LEVEL

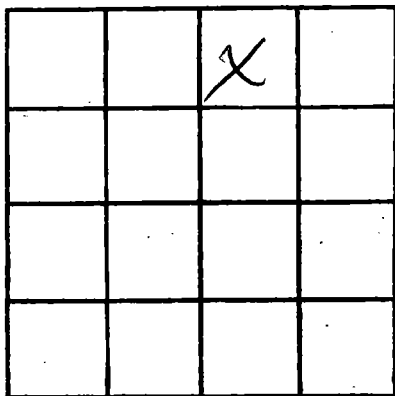

SECTION \_\_\_\_\_

Please indicate well location X.

ADDITIONAL INFORMATION

If more than one screen, show locations of each on sketch.