

MISSISSIPPI DEPARTMENT OF NATURAL RESOURCES

Bureau of Land and Water Resources

Southport Mall

P.O. Box 10631

Jackson, Mississippi 39209

WATER WELL DRILLERS LOG

CODED

Harrison
K 318
3/9/85

March 9 1985
date well completed

Mc Gill Well Works
firm name

Harrison
county well located

LANDOWNER: Mack Daigraport
25 Bayou Drive
Pass Christian, Ms.
(mailing address)

WELL LOCATION:
sec. 30 T-7 N R-12 E
7 miles N of Pass Chr.
(distance) (direction) (nearest town)

WELL PURPOSE:
(home, irrigation, municipal, industrial)

WELL COMPLETION DATA:
(1) diameter (inches) 2"
(2) total depth (feet) 320'
(3) static water level (feet) 35 below top of ground.
(4) casing PVC Sch. 40, 310' (material) (depth)
If telescope see back.
(5) screen 10' 310' (length) (depth to top)
2" Sch 80 6 slot (size) (material)
(6) pump 1 9 (HP) (yield gpm)
FLEC (type power)
(7) electric log (yes or no)
(organization running log)
(8) how well bottom plugged SAND SHARK


description of formations encountered	CODED from	to
Mud/Sand	0	20
Mud	20	40
Mud	40	60
Mud	60	80
Mud	80	100
Mud	100	120
Mud	120	140
Mud	140	160
Mud/Sand	160	180
Mud/Sand	180	200
Mud/Sand	200	220
Mud	220	240
Mud	240	260
Mud	260	280
Mud/Sand	280	300
Sand	300	320

JUN -4 1985

DRILLERS REMARKS:

If well telescopes please sketch and show depths.

GROUND LEVEL

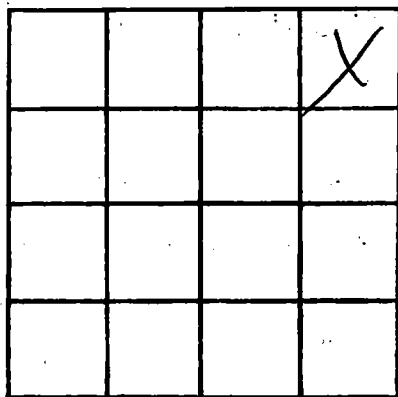

SECTION _____

Please indicate well location X.

ADDITIONAL INFORMATION

If more than one screen, show locations of each on sketch.