

MISSISSIPPI DEPARTMENT OF NATURAL RESOURCES

Bureau of Land and Water Resources

Southport Mall

P.O. Box 10631

Jackson, Mississippi 39209

WATER WELL DRILLERS LOG

CODED

Harrison
K319
3/15/85

315 1985 Mc Hill Well Works Harrison
date well completed firm name county well located

LANDOWNER: Deco Constructors

Long Beach
(mailing address)

WELL LOCATION:

sec. 11 T. 7 N R. 12 E
3 miles N of L.B.
(distance) (direction) (nearest town)

WELL PURPOSE:

(home, irrigation, municipal, industrial)

WELL COMPLETION DATA:

- (1) diameter (inches) 2"
- (2) total depth (feet) 600'
- (3) static water level (feet) 50' below above top of ground.
- (4) casing PVC Sch 40 590'
(material) (depth)
(size) if telescope see back.
- (5) screen 10' 590'
(length) (depth to top)
2" Sch 80-6 slot
(size) (material)
- (6) pump 1 8
(HP) (yield gpm)
ELEC.
(type power)
- (7) electric log _____
(yes or no)
(organization running log)

(8) how well bottom plugged sand
shank

Description of formations encountered	from	to
Sand	0	20
Sand	20	80
Sand/Mud	80	120
Mud	120	240
Mud/Sand	240	260
Mud	260	280
Sand/Mud	280	300
Mud	300	420
Sand	420	440
Sand/Mud	440	480
Mud	480	540
Mud/Sand	540	560
Sand	560	580
Sand/Gravel	580	600

CODED

RECEIVED


JUN 4 1985

DRILLERS REMARKS:

Department of Natural Resources
Bureau of Land & Water Resources

If well telescopes please sketch and show depths.

GROUND LEVEL

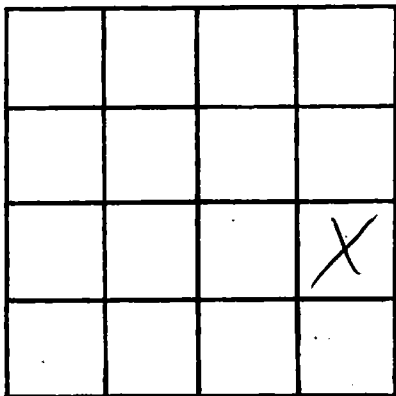

SECTION _____

Please indicate well location X.

ADDITIONAL INFORMATION

If more than one screen, show locations of each on sketch.