

MISSISSIPPI DEPARTMENT OF NATURAL RESOURCES  
Bureau of Land and Water Resources

Southport Mall  
P.O. Box 10631

CODED

Jackson, Mississippi 39209  
WATER WELL DRILLERS LOG

HARRISON  
K 320

5/7/85 19  
date well completed

Lynmar Well Co  
firm name

Harrison  
county well located

LANDOWNER: Fred Ware  
Rt. 3, Box 29  
Gulfport, Md 39503  
(mailing address)

description of formations encountered

from to

Red sand	0	80
gray mud	80	140
blue clay	140	304
lime sand blue	304	344

WELL LOCATION:

sec 9 T 7 N R 7 E  
S W  
6 miles south of LISANA  
(distance) (direction) (nearest town)

CODED

WELL PURPOSE:

(home, irrigation, municipal, industrial)

WELL COMPLETION DATA:

- diameter (inches) 4x2
- total depth (feet) 344'
- static water level (feet) 55' below top of ground
- casing PVC 324' (material) (depth)  
4x2 (size) if telescope see back.
- screen 20' 324' (length) (depth to top)  
2" PVC (size) (material)
- pump 1 (HP) 25 (yield gpm)  
electric (type power)
- electric log No (yes or no)  
No (organization running log)
- how well bottom plugged sand shark

RECEIVED


AUG 20 1985

DRILLERS REMARKS:

Department of Natural Resources  
Bureau of Land & Water Resources

If well telescopes please sketch and show depths.

GROUND LEVEL

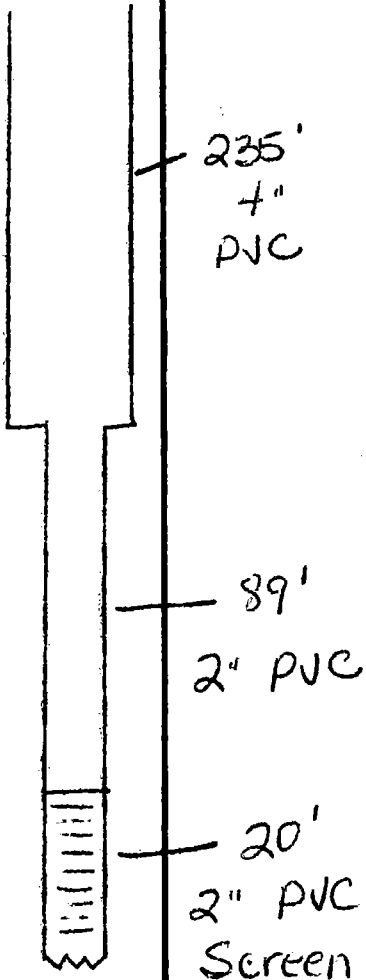

			X

SECTION 9

Please indicate well location X.

ADDITIONAL INFORMATION

If more than one screen, show locations of each on sketch.