

✓ #45

MISSISSIPPI DEPARTMENT OF ENVIRONMENTAL QUALITY

Office of Land and Water Resources

P. O. Box 10631

Jackson, MS 39289-0631

WATER WELL DRILLERS LOG

COUNTY WELL LOCATED
Harrison
 WELL NUMBER **R381** CODED
 DATE WELL COMPLETED
5-20-97

PERMIT NUMBER **0-239**
 NAME OF DRILLING FIRM
McBee

NAME & MAILING ADDRESS OF LANDOWNER
Sony Hughes
20073 Crowe Rd
Long Beach, Ms. 39560
 WELL LOCATION: SEC **34** TOWNSHIP **7 N** RANGE **12 E**
 DISTANCE _____ MILES _____ OF _____
 DIRECTION _____ NEAREST TOWN _____
 OTHER LANDMARK _____
 WELL PURPOSE: Home Irrigation, Municipal, Industrial, Fish Pond, etc.

PUMP DATA
 PUMP TYPE (Circle One): Submersible, Turbine, Jet, Flowing Well, Other (Describe) _____
 POWER TYPE (Circle One): Electric, Tractor, Diesel, Gasoline, Butane, Other (Describe) _____ H/P _____
 Pump Capacity (GPM) _____ No. of Stages _____ Setting Depth _____ FT.
 PUMP TEST
 Well yielded _____ GPM with a drawdown of _____ ft. after _____ hours of pumping

WELL DATA
 Well Depth **240** Casing Diameter (In.) **2** Casing Length (Ft.) **220**
 Type of Casing **PVC** Hole Depth **240** Depth to Static Water Level _____

LOG DATA
 TYPE OF LOG RUN (Circle One): No Log Run, Electric, Gamma Ray, Density, Sonic, Neutron, Other (Describe) _____
 Name of Organization Running Log _____

TYPE OF COMPLETION: (Circle One or More): Gravel Packed, Underreamed, Telescoped, ~~Natural Development~~, Open Hole, Other (Describe) _____

GEOLOGIC DATA (Office Use Only)

Surface Elev.	Geologic Unit	Unit Thickness	Depth to Top
Subs. SWL	Date	Analysis	Aquifer Test

WELL GROUTED TO A DEPTH OF **10** FEET
 Type Grout (circle one): Cement, Bentonite, or Mix

SCREEN DATA
 Diameter - Inches **2** Length - Feet **20** Slot Size - Inches **.006**
 Screen Type **PVC** Depth to Bottom - Feet _____

Driller's Remarks _____
 Top of Lap Pipe or Reduction in Casing _____
 FEET IF TELESCOPED OR MORE THAN ONE SCREEN: USE BACK PAGE

DESCRIPTION OF FORMATIONS ENCOUNTERED	FROM	TO
Mud	0	200
fine sand	200	220
clay	220	240

FORMATIONS (Continued) FROM TO

RECEIVED


SEP 24 1997

Dept. of Environmental Quality
 Office of Land & Water Resources

IF MORE SPACE IS NEEDED, USE BACK

If well telescopes please sketch and show depths.

GROUND LEVEL

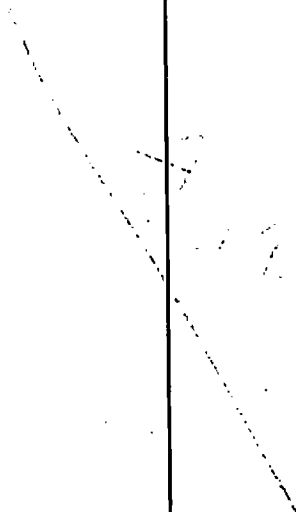

RECEIVED

If more than one screen, show location of each on sketch.

SECTION _____

Please indicate well location X.

ADDITIONAL INFORMATION

Handwritten notes and lines in the additional information section, including the word 'SECTION' and various illegible scribbles.