

MISSISSIPPI DEPARTMENT OF ENVIRONMENTAL QUALITY

Office of Land and Water Resources

P. O. Box 10631
Jackson, MS 39289-0631
WATER WELL DRILLERS LOG

COUNTY WELL LOCATED HARRISON	
WELL NUMBER R-406	CODED
DATE WELL COMPLETED 03-01-04	

PERMIT NUMBER 0239
NAME OF DRILLING FIRM McGill Pump & Well

NAME & MAILING ADDRESS OF LANDOWNER MICHAEL ASHNER Redcreek Rd.			
Latitude 30° 15' N			
Longitude 90° 15' W			
WELL LOCATION	SEC	TOWNSHIP	RANGE
	5	17	12
DISTANCE	DIRECTION		NEAREST TOWN
5	N		P.C.
OTHER LANDMARK OFF FREDDIE FRANK RD			
WELL PURPOSE: Home, Irrigation, Municipal, Industrial, Fish Pond, etc.			

PUMP DATA		
PUMP TYPE (Circle One): Submersible, Turbine, Jet, Flowing Well, Other (Describe)		
POWER TYPE (Circle One): Electric, Tractor, Diesel, Gasoline, Butane, Other (Describe) H/P		
DESCRIPTION OF FORMATIONS ENCOUNTERED	FROM	TO
SAND	0	20
MUD	20	140
SAND	140	170
MUD	170	340
SAND	340	480
RECEIVED		
MAR 12 2004		
BY: OLWR		
Top of Lap Pipe or Reduction in Casing		
FEET	IF TELESCOPED OR MORE THAN ONE SCREEN: USE BACK PAGE	

WELL DATA

Well Depth 400'	Casing Diameter (In.) 2"	Casing Length (Ft.) 380
Type of Casing PVC	Hole Depth 400'	Depth to Static Water Level 20'
TYPE OF COMPLETION: (Circle One or More): Gravel Packed , Underreamed, Telescoped, Natural Development , Open Hole, Other (Describe)		
WELL GROUTED TO A DEPTH OF 10' FEET Type Grout (circle one): Cement , Bentonite, or Mix		

SCREEN DATA

Diameter - Inches 2"	Length - Feet 20'	Slot Size - Inches .0006
Screen Type PVC	Depth to Bottom - Feet 400	

I certify that the well was drilled, constructed and completed in accordance with all applicable Requirements of the Mississippi Department of Environmental Quality and/or the Mississippi Department of Health regulations and state laws.


Michael McGill 0239
Signature of Licensed Driller and License No.

03/09/04
Date

Additional Information Required On Back

If well telescopes please sketch and show depths.

GROUND LEVEL

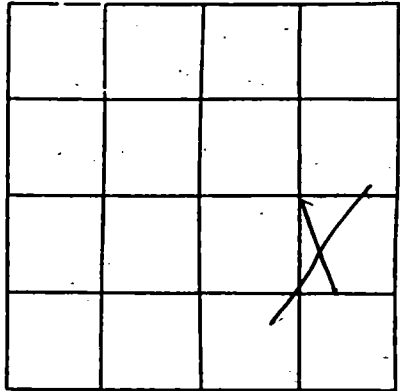

SECTION _____

Please indicate well location X.

Pump Capacity (GPM)	No. of Stages	Setting Depth	FT.
PUMP TEST			
Well yielded _____ GPM with a drawdown of _____ ft. after _____ hours of pumping			

LOG DATA

TYPE OF LOG RUN (Circle One): No Log Run
 Electric, Gamma Ray, Density, Sonic, Neutron, Other (Describe) _____

Name of Organization Running Log _____

GEOLOGIC DATA (Office Use Only)

Surface Elev.	Geologic Unit	Unit Thickness	Depth to Top
Subs. SWL	Date	Analysis	Aquifer Test

Driller's Remarks

If more than one screen, show location of each on sketch.