1 11 -	7 State We	ll Report	
County: Harrison	l Par	11 /	For Office Use Only:
Permit #:	Mississippi Department c	of Environmental Quality	Aquifer:
Driller: Lyman 1, )P/1	Unice of Land and	Water Resources	Well #: K-431
	P.O. Box Jackson, MS	X 10631 39289 0631	Well #: 1 - 121
Date drilling completed:	(601)96	1-5210	L. S. Elevation:
, , , , , , , , , , , , , , , , , , ,	(601)354-6	5938 (fax)	E-log #:
State Law requires that this rep 30 days of completion of drilling	ort be prepared by the dr	iller in detail and filed wi	th the Done
30 days of completion of drilling Well Owner Informa	i of the well.		
		Well	Location
Owner Name Harrison Count	y schools I	atitude:	'Longitude:'
Mailing Address: 11072 HW4 L	ŬG		
,	N	Aethod of Lat/Long (circle one	:): Conventional Survey,
CIC I M		USGS quad, Hand-held	GPS, Survey-grade GPS
Gultport M:		1/4 1/4 500 /6	
City Sta	- mp Couc		Iwn / Rng / Z
Telephone No. (228) 539 6508	<u>ل</u>	Distance Direction Miles	Nearest Town f
	Well Dat		•
Purpose of Well (circle one) Home			
Purpose of Well (circle one) Home	Ustrat Public Supply I	rrigation Fish Culture	Other:
Date well drilling started: 3/7/07	Date well	drilling completed. 817	 ארש
If flowing, method of flow regulation: Val	1/4 0 1	a ming completed:/	
If flowing, method of flow regulation: Val	Ve Other (desc	ribe)	
Static Water Level:feet ab	ove or below (circle one) land	surface Date measured	RICIA
Method of Measurement (circle one) ste	eel tape electric tape		
10		air line other:	
Iton dep	oth: <u>/30</u>	Well grouted to a depth of	15 500
I YDE OI PRONT (circle one)			Alle
Casing length: <u>120</u> feet Casin Screen length: <u>10</u> feet Scree			AUG 1 0 202
itet Casin	g diameter: <u>7</u> it	tches Type of casing:	DVC OF ST.
Screen length: 10 feet Scree	en diameter: 4 ;	nohen The c	<b>/ · · · · · ·</b>
Screen length: 10 feet Screen Screen slot size:f06 inches		ivenes i ype of screen:	K Wrap
	ociding deput: From/	20 feet to 12	feet
Type of completion (circle all applicable):	Gravel packed Underream		ole Natural Developmen
	. C		
Top of lap pipe or reduction in casing		· · · · · · · · · · · · · · · · · · ·	
Top of lap pipe or reduction in casing:	teet. If telesc	oped or more than one scree	n, describe on back of page
- go run (circle all applicable): No log run	) Electric Gamma Ray De	ensity Sonic Neutron	there
Traile UI OF 9801791100 Binning log(-)			
r certify that the well was drilled, constru-	cted, and completed in access		·····
I certify that the well was drilled, constru- Department of Environmental Quality and	d/or the Mississients	cance with all applicable re-	quirements of the Mississip
County all	the massarph Departm	aent of Health regulations ar	id state laws.
Josh hadner 0-64	18		1
<u>Sish hadner</u> 0-64 Print Name of Water Well Contractor and L	18	- Califer	h

•

K-431


The sheet balon only required for water wells

Description of form otions oncountered neura he provided for all wells and borcheles, unless succificativ ecompted by regulations

If well interspect, they' depths on shetch. Ground Lavel

Const Sandtzieve Blue clay Med Run Sand	Onund Lovel	1
CONFSC SANDTSMAN		
	6	130
placeday .	30	120
Medelinson	1 720	1170
	·	1
	+	+
	· [	+
		1
•		1
	1	+
		+
	+	
		1
	1	T
	1	1

If more than one screen, show location of each on skeach

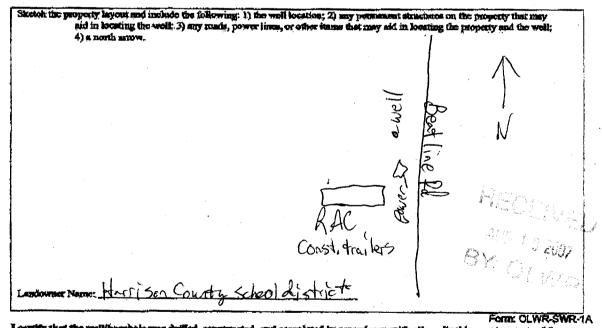

I cartify that the well/becohole was drilled, estatracted, and completed in accordance with all applicable requirements of the Mississippi Department of Eavironmental Quality and the Mississippi Department of Health regulations, & applicable, and state

Jogh od a o m

Liste

Frint Name of Respon dibio Licenne a second back

0-61

Signature of Licensee

County: Haccison	STATE WELL REPORT Part 2 Pump Installaria Completion Perent		
Permit #:	Mississippi Department of Environmental Quality		
Driller: Lynan Well	P.O.	and Water Resources Box 10631	
Date completed: $8/8/07$		MS 39289-0631 )961-5210	
		54-6938 (fax)	
This report should be prepared by t installation of pump.	he pump installer in det	ail and filed with the Department within 30 days of the	
Well Owner Informs		Well Location	
Owner Name: Harrison County Schools		Latitude:Longitude:	
Mailing Address: 11072 Hay 49		Method of Lat/Long (circle one): Conventional Survey,	
······································		USGS quad, Hand-held GPS, Survey-grade GPS	
Gyfort MS	39503	14 14 Sec 16 Twn 75 Rng 124	
City State	Zip Code	Distance Direction Nearest Town	
Telephone No. (221) 539-650	8	Miles of	
Pump Type Circle one		Power Type Circle one	
Air Lift Jet	Submersible	Diesel Engine Gasoline Engine Natural G	
Bucket Piston	Turbine <	Electric Motor Hand Tractor PT	
Centrifugal Rotary	Flowing Well	Windmill Other (specify):	
Other (specify):	U U	Horse Power Rating of Motor: $2Hp$	
Date Pump Installed:		Setting Depth: 80 feet	
Rated Pump Capacity:35	Gallons Per Minute		
		Number of Stages:	
Pump Test Data		Method of Measuring Water Level	
Date Well Tested: Notest f		Circle one	
Static Water Level (A): <u>2/</u> Fer	t Below Land Surface	Air Line Electric Measuring Line Steel Tape	
Pumping Water Level (B):Fee	t Below Land Surface	Other (specify):	
Drawdown [(B) – (A)]:Fee		For flowing well, measured shut in head:fe	
Test Pumping Rate:			
Duration of Pump Test (minimum 4 hours		Well yieldedGPM with a drawdown of	
		feet afterhours of pumpi	
I HEREBY CERTIFY that the above state	ments are tracks that		
_ Boshhadner O-C.		or my knowledge.	
Print Name of Pump Installer and License		Signature of Pump Installer	