

STATE WELL REPORT

Part 1

Driller's Log

Mississippi Department of Environmental Quality
Office of Land and Water Resources
P.O. Box 2309
Jackson, MS 39225-2309
(601)961-5210
(601)360-0535 (fax)

For Office Use Only:

Well #: K464
Aquifer: _____
E-Log #: _____

County: Harrison
Permit #: 0239
Driller: McBill Pump & Well
Date drilling completed: 10-6-16

State Law requires that this report be prepared by the license holder responsible for the work and filed with the Department at the above address within 30 days of completion of drilling of the well or borehole.

Well Owner Information <small>(Landowner if borehole is not for a water well)</small>	Well or Borehole Location
Owner Name: <u>Tony Stapleton</u>	Latitude: <u>30° 27' 6.18" N</u> Longitude: <u>89° 9' 47.9" W</u>
Mailing Address: <u>11373 Allen Rd</u>	Method of Lat/Long (check one): Conventional Survey _____
<u>Gulfport</u> MS <u>39503</u>	USGS quad _____, Hand-held GPS <input checked="" type="checkbox"/> , Survey-grade GPS _____
City State Zip Code	<u>SE 1/4 NW 1/4, Sec 11 T 75 R 12 W</u>
Telephone No. <u>(228) 328-9174</u>	<u>10.2</u> Miles <u>East</u> <u>Long Beach</u>
	(Distance) (Direction) (Nearest Town)

Well / Borehole Data

Date drilling started: 10-5-16 Date drilling completed: 10-6-16 Hole depth: 500 Hole diameter: 4x2

Location of the source of any surface water used for drilling: well water

Method of dosing and volume of Chlorine used in drilling and development: NA

Logs run (circle all applicable): No log run Electric Gamma Ray Density Sonic Neutron Other: _____

Name of organization running log(s): NA

Purpose of borehole (circle one): Water Well Geotechnical/Geological Investigation Ground Source Heat Pump
Seismic Survey Other (describe) _____

If drilling is not related to water well construction, skip the remainder of this block

Purpose of Well (circle all applicable): Home Industrial Public Supply Irrigation Fish Culture

Other (describe): _____

If a flowing well, method of flow regulation: Valve _____ Other (describe) Back Wash Valve

Static Water Level: 60 feet [above or below] land surface Date measured: 10-7-16
(circle one)

Method of measurement (circle one): Steel tape Electric tape Air line Other (describe): _____

Well depth: 500 Well grouted to a depth of: 10 feet Type of grout (circle one): Neat Cement Bentonite Mix

Casing length: 480 feet Casing diameter: 4x2 inches Type of casing: PVC

Screen length: 20 feet Screen diameter: 2 inches Type of screen: PVC

Screen slot size: .006 inches Setting depth: From 480 feet to 500 feet

Type of completion (circle all applicable): Gravel packed Underreamed Open hole Natural Development

Other (describe): _____

Top of lap pipe or reduction in casing: 180 feet

If telescoped or more than one screen, describe on next page

RECEIVED

NOV 09 2016

OLWR

STATE WELL REPORT

Part 2

Pump Installer's Completion Report

Mississippi Department of Environmental Quality
Office of Land and Water Resources
P.O. Box 2309
Jackson, MS 39225-2309
(601)961-5210
(601) 360-0535 (fax)

For Office Use Only:

Well #: KA64
Aquifer: _____

County: Harrison
Permit #: 0239
Driller: Mc Gill Pump & Well
Date completed: 10-6-16
Copy information from block on Part 1

This part of the report must be completed by a licensed water well contractor or a licensed pump installer. A copy of Part 1 of the report must be attached and both parts filed with the Department at the above address within 30 days of well completion.

Well Owner Information	Well Location
Owner Name: <u>Tony Stapleton</u>	Latitude: <u>30° 27' 6.18" N</u> Longitude: <u>89° 9' 47.9" W</u>
Mailing Address: <u>11373 Allen Rd</u>	Method of Lat/Long (check one): Conventional Survey _____, USGS quad _____, Hand-held GPS <input checked="" type="checkbox"/> , Survey-grade GPS _____
<u>Bayport</u> MS <u>39503</u>	SE 1/4 NW 1/4, Sec. <u>8</u> T <u>75</u> R <u>12W</u>
City State Zip Code	<u>10.2</u> Miles <u>East</u> of <u>Lons Beach</u>
Telephone No. <u>(728) 328-9174</u>	(Distance) (Direction) (Nearest Town)

Pump Type (circle one)

Submersible Turbine Air Lift Centrifugal Flowing Well Jet Piston Rotary Other (describe): _____

Date Pump Installed: 10-7-16 Rated Pump Capacity: 30 Gallons Per Minute

Is This Pump (circle one): New Repaired Replacement

Power Type (circle one)

Electric Diesel Gasoline Natural Gas Tractor PTO Windmill Other (describe): _____

Horse Power Rating of Motor: 1 1/2 Setting Depth: 100 feet Number of Stages: 10

Pump Test Data for Non Flowing Well

Date Well Tested: 10-6-16 Duration of Pump Test (minimum 4 hours): 4 hours

Static Water Level (A): 60 Feet Below Land Surface Pumping Water Level (B): 100 Feet Below Land Surface

Drawdown [(B) - (A)]: 10 Feet Below Land Surface Test Pumping Rate: 50 Gallons Per Minute

Method of measurement (circle one): Steel tape Electric tape Air line Other (describe): _____

Pump Test Data for Flowing Well

Measured shut in head: _____ feet. N A

Well yielded _____ GPM with a drawdown of _____ feet after _____ hours of pumping

Meter Installation N A

Meter Manufacturer: _____ Meter Serial Number: _____

Meter Model Number/Name: _____ Type of Meter: _____

Totalizer Register Unit and Multiplier Factor (AF x .001, gal x 1000, etc): _____

Installation Date: _____ Meter installed by: _____

Is This Meter (circle one): New Repaired Replacement

Important: By submitting the above information you are certifying that this meter was installed to manufacturer standards. For agricultural wells, a list of approved meters is on the MDEQ website.

I HEREBY CERTIFY that the above statements are true to the best of my knowledge.

Michael P. McCall #0239 11/16/16 [Signature] NOV 09 2016

Print Name of Pump Installer and License No. (if applicable) Date Signature of Pump Installer

The first part of the document discusses the importance of maintaining accurate records of all transactions. It emphasizes that every entry should be supported by a valid receipt or invoice. This ensures transparency and allows for easy verification of the data.

In the second section, the author details the various methods used to collect and analyze the data. This includes both manual and automated processes. The goal is to ensure that the information gathered is both reliable and comprehensive.


The third section focuses on the results of the analysis. It shows that there is a clear trend in the data, which suggests that the current strategy is effective. However, there are some areas where improvement is needed, particularly in terms of efficiency and cost reduction.

Finally, the document concludes with a series of recommendations for future action. These include implementing new software tools, training staff on best practices, and conducting regular audits to ensure ongoing compliance and accuracy.

The sketch below only required for water wells

Description of formations encountered must be provided for all wells and boreholes, unless specifically exempted by regulations

If well telescopes, show depths on sketch

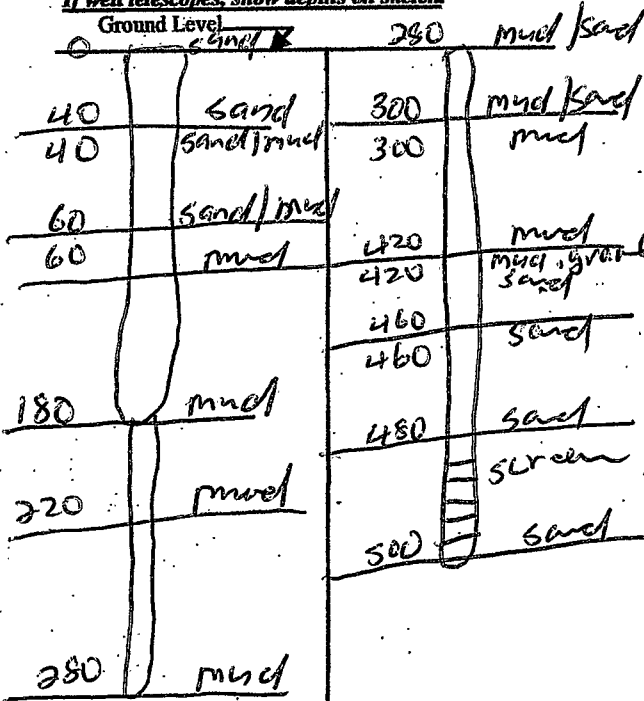

Description of Formations Encountered	From (depth)	To (depth)
	Ground Level	
sand	0	40
sand/mud	40	60
mud	60	280
mud/sand	280	300
mud	300	420
Sand, gravel mud	420	460
Sand	460	500

If more than one screen, show location of each on sketch

Sketch the property layout and include the following: 1) the well location; 2) any permanent structures on the property that may aid in locating the well; 3) any roads, power lines, or other items that may aid in locating the property and the well; 4) a north arrow.

See Back
page

Landowner Name: Tony Stapleton




Form: OLWR-SWR-1A

I certify that the well/borehole was drilled, constructed, and completed in accordance with all applicable requirements of the Mississippi Department of Environmental Quality and the Mississippi Department of Health regulations, if applicable, and state laws.

Michael McNeill #0229 11/6/16 [Signature]
 Print Name of Responsible Licensee and License No. Date Signature of Licensee

RECEIVED
 NOV 09 2016
 BY OLWR

Landon Rd

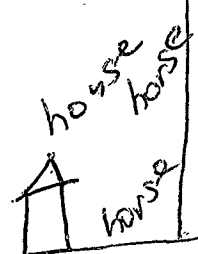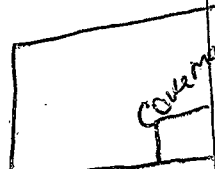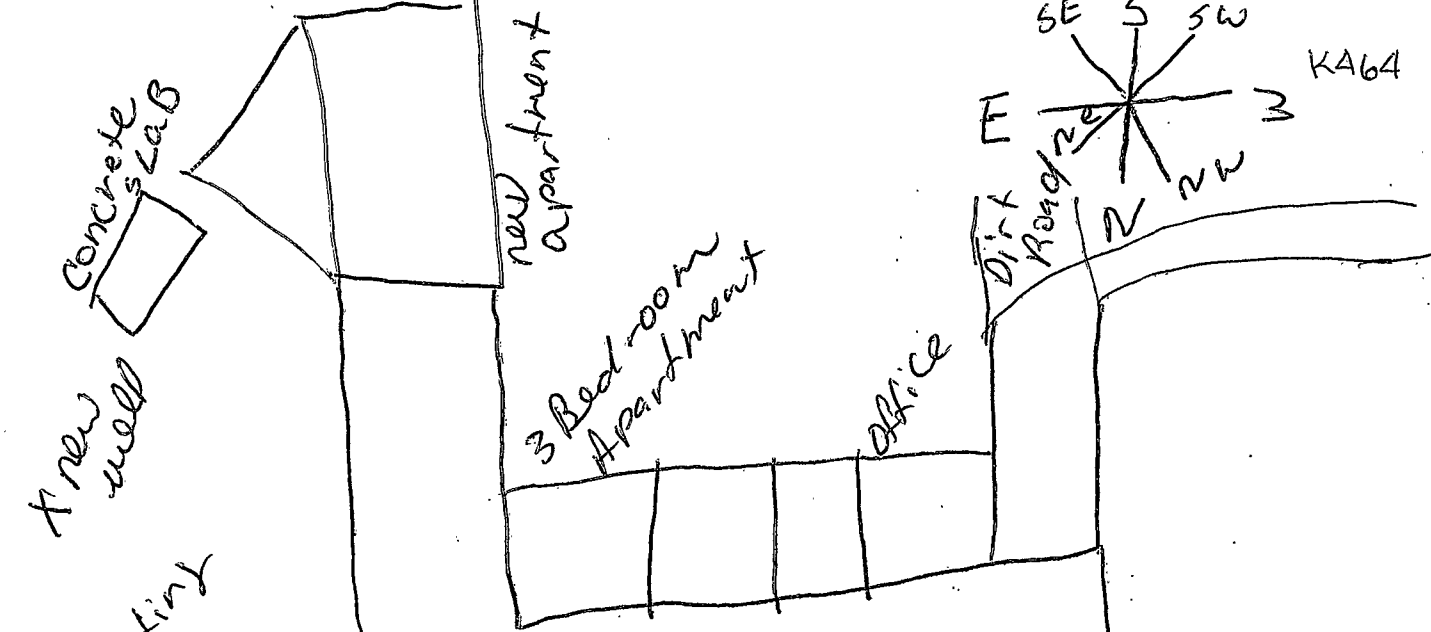


concrete Driveway

113730 Allen Rd

Horse man

Allen Rd

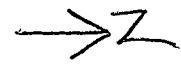

RECEIVED
NOV 09 2016
BY OLWR