

# STATE WELL REPORT

## Part 1

### Driller's Log

Mississippi Department of Environmental Quality  
Office of Land and Water Resources  
P.O. Box 2309  
Jackson, MS 39225-2309  
(601)961-5555  
(601)961-5228 (fax)

### For Office Use Only:

Well #: KATI  
Aquifer: \_\_\_\_\_  
E-Log #: \_\_\_\_\_

County: Harrison  
Permit #: 0239  
Driller: McBill Pump & Well  
Date drilling completed: 8-7-18

*State Law requires that this report be prepared by the license holder responsible for the work and filed with the Department at the above address within 30 days of completion of drilling of the well or borehole.*

Well Owner Information <small>(Landowner if borehole is not for a water well)</small>	Well or Borehole Location
Owner Name: <u>Sandra Norwood</u>	Latitude: <u>30° 26' 9.25" N</u> Longitude: <u>89° 8' 41.95" W</u>
Mailing Address: <u>New Dwelling AD</u>	Method of Lat/Long (check one): Conventional Survey _____
<u>address Landon Rd</u>	USGS quad _____, Hand-held GPS <input checked="" type="checkbox"/> , Survey-grade GPS _____
<u>Gulfport MS 39503</u>	<u>SW 1/4 NE 1/4, Sec 13 T 75 R 12W</u>
City _____ State _____ Zip Code _____	<u>0</u> Miles <u>0</u> of <u>0</u>
Telephone No. <u>(228) 596-3564</u>	(Distance) (Direction) (Nearest Town)

Well / Borehole Data
Date drilling started: <u>8-7-18</u> Date drilling completed: <u>8-7-18</u> Hole depth: <u>240</u> Hole diameter: <u>3 X 2</u>
Location of the source of any surface water used for drilling: <u>well water</u>
Method of dosing and volume of Chlorine used in drilling and development: <u>NA</u>
Logs run (check all applicable): <input type="checkbox"/> log run <input type="checkbox"/> Electric <input type="checkbox"/> Gamma Ray <input type="checkbox"/> Density <input type="checkbox"/> Sonic <input type="checkbox"/> Neutron Other: <u>NO LOG RUN</u>
Name of organization running log(s): <u>NA</u>
Purpose of borehole (check one): Water Well <input checked="" type="checkbox"/> Geotechnical/Geological Investigation <input type="checkbox"/> Ground Source Heat Pump <input type="checkbox"/> Seismic Survey Other (describe) _____

*If drilling is not related to water well construction, skip the remainder of this block*

Purpose of Well (check all applicable): <input checked="" type="checkbox"/> Home <input type="checkbox"/> Industrial <input type="checkbox"/> Public Supply <input type="checkbox"/> Irrigation <input type="checkbox"/> Fish Culture
Other (describe): _____
If a flowing well, method of flow regulation: Valve _____ Other (describe) <u>Back wash valve</u>
Static Water Level: <u>20</u> feet <input type="checkbox"/> above or <input checked="" type="checkbox"/> below land surface Date measured: <u>8-7-18</u>
Method of measurement (check one) <input checked="" type="checkbox"/> Steel tape <input type="checkbox"/> Electric tape <input type="checkbox"/> Air line <input type="checkbox"/> Other (describe): _____
Well depth: <u>240</u> Well grouted to a depth of: <u>10</u> feet Type of grout (check one) <input checked="" type="checkbox"/> Neat Cement <input type="checkbox"/> Bentonite <input type="checkbox"/> Mix
Casing length: <u>220</u> feet Casing diameter: <u>3 X 2</u> inches Type of casing: <u>PVC</u>
Screen length: <u>20</u> feet Screen diameter: <u>2</u> inches Type of screen: <u>PVC</u>
Screen slot size: <u>.006</u> inches Setting depth: From <u>220</u> feet to <u>240</u> feet
Type of completion (check all applicable) <input type="checkbox"/> gravel packed <input type="checkbox"/> Underreamed <input type="checkbox"/> Open hole <input checked="" type="checkbox"/> Natural Development
Other (describe): _____
Top of lap pipe or reduction in casing: <u>160</u> feet

*If telescoped or more than one screen, describe on next page*

*[Faint, illegible text, possibly bleed-through from the reverse side of the page]*

CHINA

# STATE WELL REPORT

## Part 2

**Pump Installer's Completion Report**  
 Mississippi Department of Environmental Quality  
 Office of Land and Water Resources  
 P.O. Box 2309  
 Jackson, MS 39225-2309  
 (601)961-5210  
 (601) 360-0535 (fax)

County: Harrison  
 Permit #: 0239  
 Driller: ML Gill Pump & Well  
 Date completed: 8-8-18  
*Copy information from block on Part 1*

**For Office Use Only:**

Well #: K471  
 Aquifer: \_\_\_\_\_

*This part of the report must be completed by a licensed water well contractor or a licensed pump installer. A copy of Part 1 of the report must be attached and both parts filed with the Department at the above address within 30 days of well completion.*

Well Owner Information	Well Location
Owner Name: <u>Sandra Norwood</u>	Latitude: <u>30° 36' 9.25" N</u> Longitude: <u>89° 8' 41.95" W</u>
Mailing Address: <u>New Dunally rd</u> <u>address Landon Rd</u>	Method of Lat/Long (check one): Conventional Survey _____, USGS quad _____, Hand-held GPS <input checked="" type="checkbox"/> , Survey-grade GPS _____
City: <u>Gulfport</u> State: <u>MS</u> Zip Code: <u>39503</u>	<u>SW 1/4 NE 1/4, Sec 13 T 75 R 12W</u>
Telephone No. <u>(228) 596-3564</u>	<u>0</u> Miles <u>0</u> of <u>0</u> (Distance) (Direction) (Nearest Town)

**Pump Type (check one)**

Submersible  Turbine  Air Lift  Centrifugal  Flowing Well  Jet  Piston  Rotary  Other (describe): \_\_\_\_\_

Date Pump Installed: 8-8-18 Rated Pump Capacity: 22 Gallons Per Minute

Is This Pump (check one):  New  Repaired  Replacement

**Power Type (check one)**

Electric  Diesel  Gasoline  Natural Gas  Tractor PTO  Windmill  Other (describe): \_\_\_\_\_

Horse Power Rating of Motor: 1 Setting Depth: 80 feet Number of Stages: 8

**Pump Test Data for Non Flowing Well**

Date Well Tested: 8-8-18 Duration of Pump Test (minimum 4 hours): 4 hours

Static Water Level (A): 20 Feet Below Land Surface Pumping Water Level (B): 80 Feet Below Land Surface

Drawdown [(B) - (A)]: 0 Feet Below Land Surface Test Pumping Rate: 22 Gallons Per Minute

Method of measurement (check one): Steel tape  Electric tape  Air line  Other (describe): \_\_\_\_\_

**Pump Test Data for Flowing Well** NA

Measured shut in head: \_\_\_\_\_ feet.

Well yielded \_\_\_\_\_ GPM with a drawdown of \_\_\_\_\_ feet after \_\_\_\_\_ hours of pumping

**Meter Installation** NA

Meter Manufacturer: \_\_\_\_\_ Meter Serial Number: \_\_\_\_\_

Meter Model Number/Name: \_\_\_\_\_ Type of Meter: \_\_\_\_\_

Totalizer Register Unit and Multiplier Factor (AF x .001, gal x 1000, etc): \_\_\_\_\_

Installation Date: \_\_\_\_\_ Meter installed by: \_\_\_\_\_

Is This Meter (check one):  New  Repaired  Replacement

*Important: By submitting the above information you are certifying that this meter was installed to manufacturer standards. For agricultural wells, a list of approved meters is on the MDEQ website.*

RECEIVED  
 SEP 11 2018  
 BY OLWR

I HEREBY CERTIFY that the above statements are true to the best of my knowledge.


Michael McCall # 0239 9/3/18 \_\_\_\_\_  
 Print Name of Pump Installer and License No. (if applicable) Date Signature of Pump Installer

County: Harrison  
 Permit #: 0239

**For Office Use Only:**  
 Well #: K471

*The sketch below only required for water wells*

*If well telescopes, show depths on sketch.*

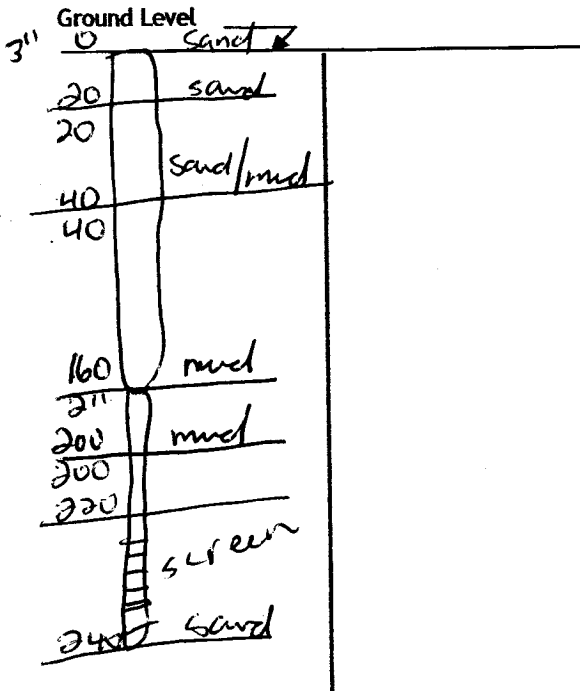

If more than one screen, show location of each on sketch

*Description of formations encountered must be provided for all wells and boreholes, unless specifically exempted by regulations*

Description of Formations Encountered	From (depth) Ground level	To (depth)
Sand	0	20
Sand/mud	20	40
mud	40	200
Sand	200	240

- Sketch the property layout and include the following:
- 1) the well location
  - 2) any permanent structures on the property that may aid in locating the well
  - 3) any roads, power lines, or other items that may aid in locating the property and the well
  - 4) north arrow

See Back page

RECEIVED  
 SEP 11 2018  
 BY OLWR

Landowner Name: Sandra Norwood

I HEREBY CERTIFY that the well/borehole was drilled, constructed, and completed in accordance with all applicable requirements of the Mississippi Department of Environmental Quality and the Mississippi Department of Health regulations, if applicable, and state laws.

Michael McCall SR # 0239      9/7/18      [Signature]  
 Print Name of Responsible Licensee and License No.      Date      Signature of Licensee

Handwritten notes at the top of the page, including a date and some illegible text.

Handwritten notes in the middle section, possibly describing a process or experiment.

Handwritten notes in the lower middle section, continuing the previous text.

Handwritten notes in the lower section, including a date and some illegible text.

Handwritten notes at the bottom of the page, including a date and some illegible text.

Canal Rd

K471

Landon Rd

Hutter Rd

Central Baptist Church

Clay Rd



RECEIVED  
SEP 11 2018  
BY OLWR

X well

Tree

7th Ave  
Private

North  
Bayou Bernard Rd

Bayou Bernard Rd

1945

1945

