	STATE WELL REPORT	58
	Part 1	Far Office Use Or
county: Marrison	Driller's Log Mississippi Department of Environmental Quality	For Office Use Or Well #:K 4'7
Permit #: 0239	Office of Land and Water Resources	Aquifer:
Driller: MC Gill pumpt	Util P.O. Box 2309 Jackson, MS 39225-2309	E-Log #:
Date drilling completed: $9-24-18$	(601)961-5555	E-Log #.
	(601)961-5228 (fax)	
	be prepared by the license holder responsible for t ithin 30 days of completion of drilling of the well	
Well Owner Informat (Landowner if borehole is not for		hole Location
Owner Name: John Forb	Latitude: 30 06 30.6 / Lor	ngitude: <u>89 9 15.</u> 6
	Mathad of Lat /Lang (chack and	e): Conventional Survey_
Mailing Address: 10523 Be	USGS quad, Hand-held G	PS / Survey-grade GP
Pd		1
Gulfport ms City State	39503 NE 4 NE 4, Sec_	_
-	5^{-} Miles $5W$ 0	
Telephone No. (228) 832-3	(Distance) (Direction)	(Nearest Town)
	Well / Borehole Data	
Date drilling started: $9 - 24 - 18$ Date	drilling completed: 9-24-18 Hole depth: 26	$\underline{0}$ Hole diameter: $\underline{3}$
Location of the source of any surface w	vater used for drilling: <u>well</u> water	
Method of dosing and volume of Chlori	ne used in drilling and development: <u>NA</u>	
Logs run (check all applicable):	un Electric Gamma Ray Density Sonic Neutro	on Other: NO LOS
Name of organization running log(s):	A	
	Well Geotechnical/Geological Investigation	Ground Source Heat Pump
	ic Survey Other (describe)	
	ated to water well construction, skip the remainder	
	Home Industrial Public Supply Irrigation	_IFISH Culture
Other (describe):	ß a	le contra la la
If a flowing well, method of flow regul	ation: Valve Other (<i>describe</i>) <u>DG</u>	<u>CK Wash V</u>
Static Water Level: <u>30</u> feet	ation: Valve Other (<i>describe</i>) <u>Bg</u> Dabove or below] land surface Date measur (check one)	red: <u>9-24-18</u>
Method of measurement (check one)	Steel tape Electric tape Air line Other (<i>describe</i>):
Well depth: <u>260</u> Well grouted to a	depth of:feet Type of grout (check one)	Neat Cement Bentonite
_	asing diameter: 3×2 inches Type of a	
Screen length: <u>20</u> feet S	creen diameter:inches Type of	screen: PVC
Screen slot size: <u>006</u> inches	Setting depth: From $\underline{\mathcal{I}}\underline{\mathcal{I}}\underline{\mathcal{I}}$ feet to	, <u>260</u> feet
Type of completion (check all applicabl	e) ravel packed Underreamed Open hole	Natural Development
Other (describe):		
Top of lap pipe or reduction in casing:	<u> </u>	
· · · · · · · · · · · · · · · · · · ·	oped or more than one screen, describe on next pa	

Form: OLWR-SWR-1A (4/13)



antina da ser en esta da ser en entre da ser en esta da ser en esta da ser en entre en entre en entre en entre Esta da ser entre Esta da ser entre entre


	ELL REPORT	
County: Harrison	Part 2	For Office Use C
Mississippi Departm	er's Completion Report nent of Environmental Quality	Well #:
Driller: mcbill penp ture Office of Lar	nd and Water Resources	·······
	.O. Box 2309 In, MS 39225-2309	Aquifer:
<u>Copy information from block on Part 1</u> (6	501)961-5210	
•) 360-0535 (fax)	
This part of the report must be completed by a licensed water of the report must be attached and both parts filed with the D	• well contractor or a licensed pur Department at the above address w	np installer. A copy of P vithin 30 days of well con
Well Owner Information	Well L	ocation
Owner Name: John Forbes	Latitude: 30 26 2667 Lon	gitude: <u>899</u> 15
Mailing Address: 10523 Bayou	Method of Lat/Long (check one	: Conventional Survey
Benard Ad	USGS quad, Hand-held G	-
Bulfport ms 39503	NE 1/ VE 1/4, Sec_	
<u>Gulfport</u> ms <u>39503</u> City State Zip Code	5.3 Miles $\leq W$ of	-
Telephone No. (228) 832-3368	(Distance) (Direction)	(Nearest Town)
Pump Tyr	pe (check one)	<u></u>
Submersible		scribe):
Date Pump Installed: 9-25-18	Rated Pump Capacity:	C Gallons Pe
Is This Pump (check one): New Repaired Replacemer		Outions Fit
	pe (check one)	
Electric Diesel Gasoline Natural Gas	• •	
Horse Power Rating of Motor: Setting Dept		
	· · · · · · · · · · · · · · · · · · ·	or stuges
Date Well Tested: 9-25-18	for Non Flowing Well Duration of Pump Test (minim	um 4 hours): <u> </u>
Static Water Level (A): Feet Below Land Surface		
Drawdown [(B) - (A)]:Feet Below Land Surf	face Test Pumping Rate:	10 Gallons Pe
Method of measurement (check one): Steel tape	ape 🛛 Air line 🗍 Other (<i>describe</i>):	
Pump Test Dat	ta for Flowing Well NV A	~
Measured shut in head:feet.		
Well yieldedGPM with a drawdown of	feet after	hours of pumping
Meter	Installation VA	· · · · · · · · · · · · · · · · · · ·
Meter Manufacturer:	Meter Serial Number:	
Meter Model Number/Name:		
Totalizer Register Unit and Multiplier Factor (AF x .001, gal		
• • • • •		
Installation Date: Meter installed by: _		· · · · · · · · · · · · · · · · · · ·
	ent	
Is This Meter (check one): New Repaired Replaceme		11 · 1 ·
Is This Meter (check one): New Repaired Replaceme Important: By submitting the above information you are ce For agricultural wells, a list of app	ertifying that this meter was insta proved meters is on the MDEQ w	ebsite.
. ,		uea to manujacturer star ebsite.
Important: By submitting the above information you are ce For agricultural wells, a list of app		uea to manujacturer stan ebsite.

Form:	OLWR	-SWR-2A	(4/13)

County:	Harrison
Permit #:	0239
	-

The sketch below only required for water wells

If well telescopes, show depths on sketch.

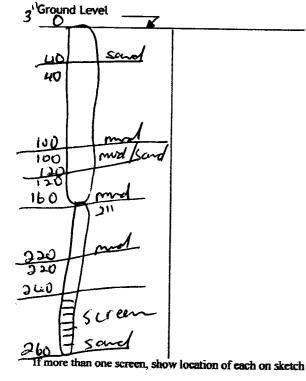

For Office Use Only:

Well #: ___

Description of formations encountered must be provided for all wells and boreholes, unless specifically exempted by regulations

Description of Formations Encountered	From (depth)	To (depth)
	Ground level	
Sand	$\square \bigcirc$	40
much	40	100
mud Sand	100	120
must	120	220
Samo	220	260
	1	
	 	
	<u> </u>	
	t	
	I [

Sketch the property layout and include the following:

1) the well location

2) any permanent structures on the property that may aid in locating the well

3) any roads, power lines, or other items that may aid in locating the property and the well

4) north arrow

see Back page

Landowner Name: John Forbes

I HEREBY CERTIFY that the well/borehole was drilled, constructed, and completed in accordance with all applicable requirements of the Mississippi Department of Environmental Quality and the Mississippi Department of Health regulations, if applicable, and state laws.

Date

M(mal M(G), 18440239 Print Name of Responsible Licensee and License No.

Signature of Licensee

Form: OLWR-SWR-1B (4/13)

.

Sec. Sec.

