

STATE WELL REPORT

48

County: Harrison
 Permit #: 0289
 Driller: McGill pump & well
 Date drilling completed: 10-23-18

Part 1
Driller's Log
 Mississippi Department of Environmental Quality
 Office of Land and Water Resources
 P.O. Box 2309
 Jackson, MS 39225-2309
 (601)961-5555
 (601)961-5228 (fax)

For Office Use Only:

Well #: K475
 Aquifer: _____
 E-Log #: _____

State Law requires that this report be prepared by the license holder responsible for the work and filed with the Department at the above address within 30 days of completion of drilling of the well or borehole.

Well Owner Information <small>(Landowner if borehole is not for a water well)</small>	Well or Borehole Location
Owner Name: <u>Arthur span</u>	Latitude: <u>30° 26' 37.71" N</u> Longitude: <u>89° 9' 57.18" W</u>
Mailing Address: <u>11080 Landon Lake Blvd</u>	Method of Lat/Long (check one): Conventional Survey _____, USGS quad _____, Hand-held GPS <input checked="" type="checkbox"/> , Survey-grade GPS _____
<u>Gulfport</u> <u>ms</u> <u>39503</u>	<u>SE 1/4 SW 1/4, Sec 11 T 75N R 12W</u>
City State Zip Code	<u>6.2</u> Miles <u>west</u> of <u>Orange Grove</u>
Telephone No. <u>(228) 365-4891</u>	(Distance) (Direction) (Nearest Town)

Well / Borehole Data

Date drilling started: 10-22-18 Date drilling completed: 10-23-18 Hole depth: 440 Hole diameter: 3 X 2

Location of the source of any surface water used for drilling: well water

Method of dosing and volume of Chlorine used in drilling and development: NA

Logs run (check all applicable): log run Electric Gamma Ray Density Sonic Neutron Other: NO LOG RUN

Name of organization running log(s): NA

Purpose of borehole (check one): Water Well Geotechnical/Geological Investigation Ground Source Heat Pump Seismic Survey Other (describe) _____

If drilling is not related to water well construction, skip the remainder of this block

Purpose of Well (check all applicable): Home Industrial Public Supply Irrigation Fish Culture

Other (describe): _____

If a flowing well, method of flow regulation: Valve _____ Other (describe) Back wash valve

Static Water Level: 50 feet above or below land surface Date measured: 10-23-18
(check one)

Method of measurement (check one) Steel tape Electric tape Air line Other (describe): _____

Well depth: 440 Well grouted to a depth of: 10 feet Type of grout (check one) Neat Cement Bentonite Mix

Casing length: 420 feet Casing diameter: 3 X 2 inches Type of casing: PVC

Screen length: 20 feet Screen diameter: 2 inches Type of screen: PVC

Screen slot size: .006 inches Setting depth: From 420 feet to 440 feet

Type of completion (check all applicable) gravel packed Underreamed Open hole Natural Development

Other (describe): _____

Top of lap pipe or reduction in casing: 200 feet

If telescoped or more than one screen, describe on next page

RECEIVED
 NOV 19 2018
 BY OLWR

RECEIVED

SAID

1914

1914

Faint, mostly illegible text covering the upper and middle portions of the page, possibly representing a list or a set of records.

STATE WELL REPORT

County: Harrison
 Permit #: 0239
 Driller: McGill Pumpwell
 Date completed: 10-23-18
Copy information from block on Part 1

Part 2
Pump Installer's Completion Report
 Mississippi Department of Environmental Quality
 Office of Land and Water Resources
 P.O. Box 2309
 Jackson, MS 39225-2309
 (601)961-5210
 (601) 360-0535 (fax)

For Office Use Only:

Well #: K475
 Aquifer: _____

This part of the report must be completed by a licensed water well contractor or a licensed pump installer. A copy of Part 1 of the report must be attached and both parts filed with the Department at the above address within 30 days of well completion.

Well Owner Information	Well Location
Owner Name: <u>Arthur Span</u>	Latitude: <u>30° 26' 37.11</u> Longitude: <u>89° 9' 57.18</u>
Mailing Address: <u>11080 Landon Lake Blvd</u>	Method of Lat/Long (check one): Conventional Survey _____, USGS quad _____, Hand-held GPS <input checked="" type="checkbox"/> , Survey-grade GPS _____
<u>Gulfport</u> <u>MS</u> <u>39503</u>	<u>SE 1/4 SW 1/4, Sec 11 T 75 R 12W</u>
City State Zip Code	<u>6.2</u> Miles <u>west</u> of <u>Orange Grove</u>
Telephone No. <u>(228) 365-4891</u>	(Distance) (Direction) (Nearest Town)

Pump Type (check one)

Submersible Turbine Air Lift Centrifugal Flowing Well Jet Piston Rotary Other (describe): _____

Date Pump Installed: 10-26-18 Rated Pump Capacity: 15 Gallons Per Minute

Is This Pump (check one): New Repaired Replacement

Power Type (check one)

Electric Diesel Gasoline Natural Gas Tractor PTO Windmill Other (describe): _____

Horse Power Rating of Motor: 1 h.p. Setting Depth: 100 feet Number of Stages: 7

Pump Test Data for Non Flowing Well

Date Well Tested: 10-26-18 Duration of Pump Test (minimum 4 hours): 4 hours

Static Water Level (A): 50 Feet Below Land Surface Pumping Water Level (B): 100 Feet Below Land Surface

Drawdown [(B) - (A)]: 0 Feet Below Land Surface Test Pumping Rate: 15 Gallons Per Minute

Method of measurement (check one): Steel tape Electric tape Air line Other (describe): _____

Pump Test Data for Flowing Well NA

Measured shut in head: _____ feet.

Well yielded _____ GPM with a drawdown of _____ feet after _____ hours of pumping

Meter Installation NA

Meter Manufacturer: _____ Meter Serial Number: _____

Meter Model Number/Name: _____ Type of Meter: _____

Totalizer Register Unit and Multiplier Factor (AF x .001, gal x 1000, etc): _____

Installation Date: _____ Meter installed by: _____

Is This Meter (check one): New Repaired Replacement

Important: By submitting the above information you are certifying that this meter was installed to manufacturer standards. For agricultural wells, a list of approved meters is on the MDEQ website.

I HEREBY CERTIFY that the above statements are true to the best of my knowledge.

Michael McGill 0239 11/16/18 [Signature]
 Print Name of Pump Installer and License No. (if applicable) Date Signature of Pump Installer

RECEIVED
 NOV 19 2018
 BY OLWR

RECEIVED
MAY 14 1964

RECEIVED
MAY 14 1964


RECEIVED
MAY 14 1964

RECEIVED
MAY 14 1964

RECEIVED
MAY 14 1964

RECEIVED
MAY 14 1964

K475

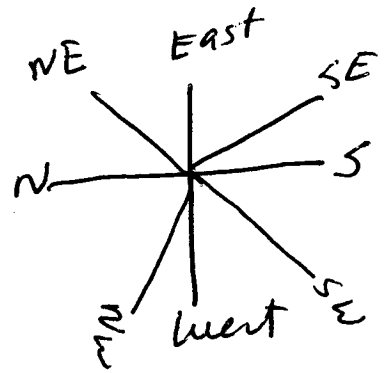

Bayou Bernard Rd

S Bayou Bernard Rd

Allen Rd

Landon Rd

Landon Lake Blvd Clay Rd


Landon Lake

11080 Landon Lake Blvd

RECEIVED
NOV 19 2018
BY OLWR

Bridge

N Turner Rd

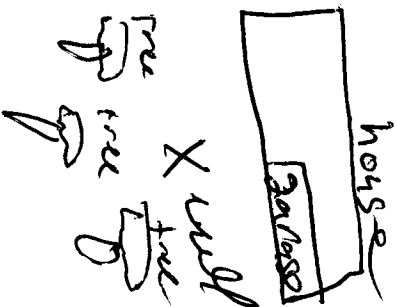

prop. to tip