

**MISSISSIPPI DEPARTMENT OF NATURAL RESOURCES**  
**Bureau of Land and Water Resources**  
 Southport Mall  
 P.O. Box 10631  
 Jackson, Mississippi 39209  
**WATER WELL DRILLERS LOG**

Harrison  
K  
2001

11-9 1983 McGill Wells, Inc. HARRISON  
 date well completed firm name county well located

**LANDOWNER:** EDNA BOWERS

Box 155L

GULFPORT MS

(mailing address)

**WELL LOCATION:**

sec 35 T 7 N R 12 E  
5 miles S of Bay  
 (distance) (direction) (nearest town)

**WELL PURPOSE:**

(home, irrigation, municipal, industrial)

**WELL COMPLETION DATA:**

- (1) diameter (inches) 3"  
 (2) total depth (feet) 730'  
 (3) static water level (feet) 12 below above top of ground.  
 (4) casing 40 PVC, 720'  
 (material) (depth)

(size) if telescope see back.

- (5) screen 10', 720'  
 (length) (depth to top)  
2", Sch 80 6 SLOT  
 (size) (material)

- (6) pump 1 (HP) 6 (yield gpm)

E.L.  
 (type power)

- (7) electric log NO  
 (yes or no)

(organization running log)

- (8) how well bottom plugged SAND SEAL

**DRILLERS REMARKS:**

description of formations encountered

from

to

mud

0 40

sand

40 60

mud

60 450

sand

450 460

mud

460 470

sand

470 500

mud

500 600

sand

600 620

mud

620 660

sand


660 730

DEPT. OF NATURAL RESOURCES  
 BUREAU OF LAND & WATER RESOURCES

**RECEIVED**

If well telescopes please sketch and show depths.

GROUND LEVEL

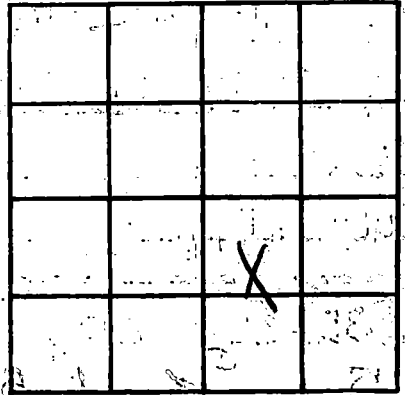

SECTION 35

Please indicate well location X.

ADDITIONAL INFORMATION

If more than one screen, show locations of each on sketch.