

MISSISSIPPI DEPARTMENT OF NATURAL RESOURCES

Bureau of Land and Water Resources

Southport Mall

P.O. Box 10631

Jackson, Mississippi 39209

WATER WELL DRILLERS LOG

HARRISON
K
2002

Sept. 26 1983 Sumner Well Drilling Harrison
date well completed firm name county well located

LANDOWNER: David Alexander

description of formations encountered

from

to

Rt. 1 Box 30

Long Beach Ms. 39560
(mailing address)

<u>clay sand mixed</u>	<u>0</u>	<u>100</u>
<u>white clay</u>	<u>100</u>	<u>220</u>
<u>fine sand</u>	<u>220</u>	<u>230</u>
<u>course sand</u>	<u>230</u>	<u>250</u>

WELL LOCATION:

sec 29 T 7 N R 12 E
7 miles N.E. of Pass Christian
(distance) (direction) (nearest town)

WELL PURPOSE:

Home
(home, irrigation, municipal, industrial)

WELL COMPLETION DATA:

- (1) diameter (inches) 2"
- (2) total depth (feet) 250'
- (3) static water level (feet) 32' below above top of ground.
- (4) casing PVC, 240'
(material) (depth)

 if telescope see back.
(size)

- (5) screen 10', 240'
(length) (depth to top)
- 2", PVC
(size) (material)

- (6) pump 1 (HP) (yield gpm)

(type power)

- (7) electric log
(yes or no)

(organization running log)

- (8) how well bottom plugged Sand

DRILLERS REMARKS: Owners had his own pump


DEPT. OF NATURAL RESOURCES
BUREAU OF LAND & WATER RESOURCES

FEB 10 1984

RECEIVED

If well telescopes please sketch and show depths.

GROUND LEVEL

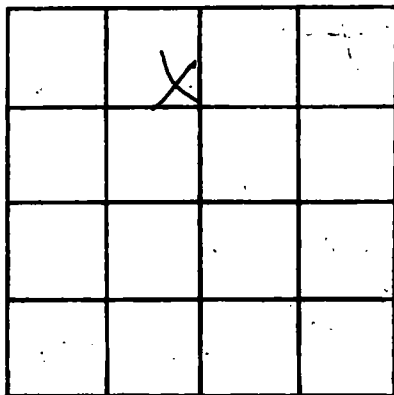

SECTION 29

Please indicate well location X.

ADDITIONAL INFORMATION

If more than one screen, show locations of each on sketch.