

MISSISSIPPI DEPARTMENT OF NATURAL RESOURCES

Bureau of Land and Water Resources

Southport Mall

P.O. Box 10631

Jackson, Mississippi 39209

WATER WELL DRILLERS LOG  
COASTAL DRILLING & SERVICE CO.

ROUTE 1 BOX 618  
firm name

BILOXI, MISS. 39532

county well located

Division  
K  
2007

2/14/83 19  
date well completed

LANDOWNER

description of formations encountered

from to

Small Briggs

<u>Top Soil</u>	<u>1</u>	<u>3</u>
<u>Red Clay</u>	<u>3</u>	<u>15</u>
<u>Soft Blue Clay</u>	<u>15</u>	<u>65</u>
<u>Super Sand</u>	<u>65</u>	<u>80</u>
<u>Soft Blue Clay</u>	<u>80</u>	<u>315</u>
<u>hard Blue Clay</u>	<u>315</u>	<u>470</u>
<u>fine water sand</u>	<u>470</u>	<u>500</u>
<u>good water sand</u>	<u>500</u>	<u>530</u>

P.O. Barry  
Bilal D.S.  
(mailing address)

WELL LOCATION:

sec. 11 T. 7 N R. 12 E  
S W  
2 1/2 miles North of T10  
(distance) (direction) (nearest town)

WELL PURPOSE: Home  
(home, irrigation, municipal, industrial)

WELL COMPLETION DATA:

- diameter (inches) 4 1/2"
- total depth (feet) 530'
- static water level (feet) 62 below above top of ground.
- casing PVC 515'  
(material) (depth)  
4 1/2" If telescope see back.  
(size)
- screen 15' 515'  
(length) (depth to top)  
2" PVC  
(size) (material)
- pump 1/2 20  
(HP) (yield gpm)  
3/4  
(type power)
- electric log no  
(yes or no)

(organization running log)

(8) how well bottom plugged  
2" thick water

DRILLERS REMARKS: 17-B

MISSISSIPPI DEPARTMENT OF NATURAL RESOURCES  
BUREAU OF LAND AND WATER RESOURCES

JUL - 2 1984

RECEIVED

If well telescopes please sketch and show depths.

GROUND LEVEL

160'-4" PVC Casing




355'-2" PVC Casing



15'-2" PVC Screen

2" back Wash Valve  
19-B

If more than one screen, show locations of each on sketch.

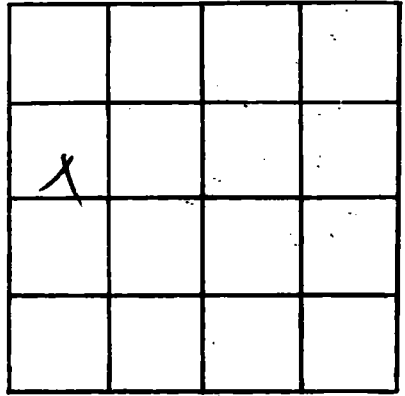

SECTION \_\_\_\_\_

Please indicate well location X.

ADDITIONAL INFORMATION

Lined area for additional information.