

MISSISSIPPI DEPARTMENT OF NATURAL RESOURCES

Bureau of Land and Water Resources

Southport Mall

P.O. Box 10631

Jackson, Mississippi 39209

WATER WELL DRILLERS LOG

Harrison
K
2008

Lyman Adell Co.
Lyman Adell

Harrison

2/20/84 19
date well completed

firm name

county well located

LANDOWNER: Jerry Holland
Rt. 2, Robinson Rd.
Georgetown, Md 39503
(mailing address)

description of formations encountered

from to

Red Clay	0	65
White Clay	65	95
Pine sand	95	130
Blue Clay	130	153
Good sand	153	170

WELL LOCATION:

sec. 1 T. 7 N. R. 12 E.
8 miles N of Get
(distance) (direction) (nearest town)

WELL PURPOSE: domestic
(home, irrigation, municipal, industrial)

WELL COMPLETION DATA:

- (1) diameter (inches) 2"
- (2) total depth (feet) 170'
- (3) static water level (feet) _____ below above top of ground.
- (4) casing PVC, 160'
(material) (depth)
- 2"
(size) If telescope see back.
- (5) screen 10', 160'
(length) (depth to top)
- 2", PVC
(size) (material)
- (6) pump 1/2
(HP) (yield gpm)
- electric
(type power)
- (7) electric log NO
(yes or no) NO
(organization running log)
- (8) how well bottom plugged sand
shark

DEPT. OF NATURAL RESOURCES
BUREAU OF LAND & WATER RESOURCES


SEP - 5 1984

RECEIVED

DRILLERS REMARKS: _____

If well telescopes please sketch and show depths.

GROUND LEVEL

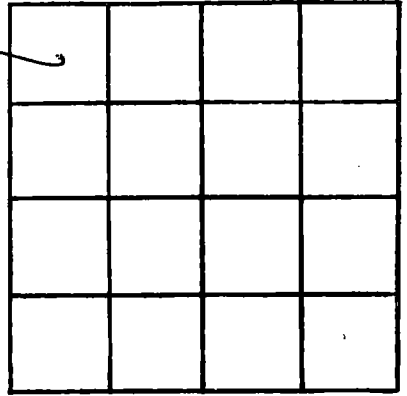

SECTION f

Please indicate well location X.

ADDITIONAL INFORMATION

If more than one screen,
show locations of each on sketch.