

Harrison
K
2009

MISSISSIPPI DEPARTMENT OF NATURAL RESOURCES
Bureau of Land and Water Resources
Southport Mall
P.O. Box 10631
Jackson, Mississippi 39209
WATER WELL DRILLERS LOG

3/13/84 19 Lyman Well Co Harrison
date well completed firm name county well located

LANDOWNER: Alvin Tharroy
Robinson Rd.
Gulfport, Md 39503
(mailing address)

description of formations encountered	from	to
<u>White Sand</u>	<u>0</u>	<u>40</u>
<u>Blue Clay</u>	<u>40</u>	<u>180</u>
<u>fine Sand</u>	<u>180</u>	<u>200</u>
<u>Good Sand</u>	<u>200</u>	<u>235</u>

WELL LOCATION:
sec. 3 T. 7 N. R. 12
7 miles N of GT
(distance) (direction) (nearest town)

WELL PURPOSE: Home
(home, irrigation, municipal, industrial)

- WELL COMPLETION DATA:
- (1) diameter (inches) 2"
 - (2) total depth (feet) 235'
 - (3) static water level (feet) 6' below top of ground.
 - (4) casing PVC, 225'
(material) (depth)
2" if telescope see back.
(size)
 - (5) screen 10', 225'
(length) (depth to top)
2", PVC
(size) (material)
 - (6) pump N/A, N/A
(HP) (yield gpm)
10/3
(type power)
 - (7) electric log No
(yes or no)
No
(organization running log)
 - (8) how well bottom plugged sand
shark

DRILLERS REMARKS: _____


DEPT. OF NATURAL RESOURCES
BUREAU OF LAND & WATER RESOURCES

SEP - 5 1984

RECEIVED

If well telescopes please
sketch and show depths.

GROUND LEVEL

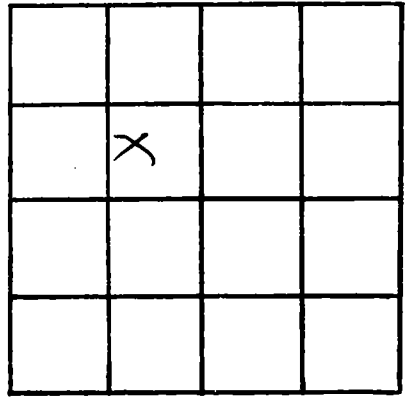

SECTION W

Please indicate well location X.

ADDITIONAL INFORMATION

If more than one screen,
show locations of each on sketch.