

MISSISSIPPI DEPARTMENT OF NATURAL RESOURCES

Bureau of Land and Water Resources

Southport Mall

P.O. Box 10631

Jackson, Mississippi 39209

WATER WELL DRILLERS LOG

Harrison
K
2012

8/9/84 date well completed
Lynnan Well Co. firm name
Harrison county well located

LANDOWNER:

Roger Smith

description of formations encountered

from

to

Rt. 2, Box 679
Gulfport, Md 39503
(mailing address)

yellow clay	0	10
white sand	11	25
yellow clay	25	151
yellow sand	152	180

WELL LOCATION:

sec. 36 T. 2 N. R. 12 E
5 miles N of Gpt
(distance) (direction) (nearest town)

WELL PURPOSE:

drinking water
(home, irrigation, municipal, industrial)

WELL COMPLETION DATA:

- (1) diameter (inches) 2"
- (2) total depth (feet) 180'
- (3) static water level (feet) 45' below top of ground
- (4) casing PVC, 170' (material) (depth)
2" (size) if telescope see back.
- (5) screen 10', 170' (length) (depth to top)
2" PVC (size) (material)
- (6) pump 1 (HP), 11 (yield gpm)
electric (type power)
- (7) electric log NO (yes or no)
NO (organization running log)
- (8) how well bottom plugged sand
shark


DRILLERS REMARKS:

DEPT. OF NATURAL RESOURCES
BUREAU OF LAND & WATER RESOURCES

DEC 10 1984
RECEIVED

If well telescopes please sketch and show depths.

GROUND LEVEL

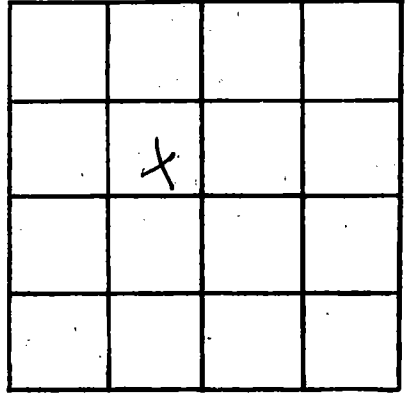

SECTION 36

Please indicate well location X.

ADDITIONAL INFORMATION

If more than one screen,
show locations of each on sketch.