

MISSISSIPPI DEPARTMENT OF NATURAL RESOURCES

Bureau of Land and Water Resources

Southport Mall

P.O. Box 10631

Jackson, Mississippi 39209

WATER WELL DRILLERS LOG

HARRISON
K 2015

3/6/85 19 Lyman Well Harrison
date well completed firm name county well located

LANDOWNER: Jack Riley
Rt. 11, Box 281
Gulfport, Md 39503
(mailing address)

description of formations encountered	from	to
Red clay	0	40
Sand fine	40	50
Blue clay	50	170
Sand Brown	170	193
Blue clay	193	250
core Sand yellow	250	280

WELL LOCATION:
sec. 1 T 7 N R 12 E
5 miles north of Gulfport
(distance) (direction) (nearest town)

WELL PURPOSE: Home
(home, irrigation, municipal, industrial)

WELL COMPLETION DATA:

- (1) diameter (inches) 2"
- (2) total depth (feet) 280'
- (3) static water level (feet) 60 below above top of ground.
- (4) casing PVC 270'
(material) (depth)
2" (size) If telescope see back.
- (5) screen 10' 270'
(length) (depth to top)
2" (size) PVC (material)
- (6) pump 1 (HP) 10 (yield gpm)
Electric (type power)
- (7) electric log NO (yes or no)
NO (organization running log)
- (8) how well bottom plugged sand Shark


DRILLERS REMARKS:

RECEIVED
AUG 20 1985

Department of Natural Resources
Bureau of Land & Water Resources

If well telescopes please sketch and show depths.

GROUND LEVEL

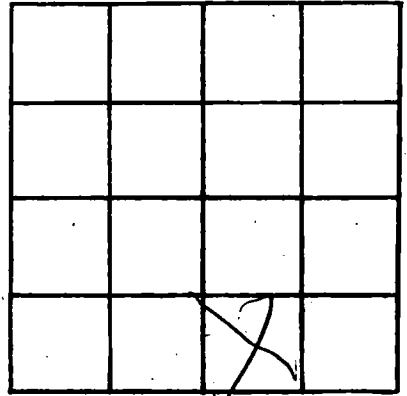

SECTION 1

Please indicate well location X.

ADDITIONAL INFORMATION

If more than one screen, show locations of each on sketch.