

MISSISSIPPI DEPARTMENT OF NATURAL RESOURCES

Bureau of Land and Water Resources

Southport Mall

P.O. Box 10631

Jackson, Mississippi 39209

WATER WELL DRILLERS LOG
 COASTAL DRILLING & SERVICE CO.

Harrison
 K 2017
 9-12-84

L

9/12/84
 date well completed

RT. 11, BOX 81
 firm name
 DIXON, MS 39532

Harrison
 county well located

LANDOWNER: Marlynda
Dedaux City
Pass Christian, MS
 (mailing address)

description of formations encountered	from	to
top soil	1	10
segsan sand	10	25
red clay	25	150
soft blue clay	150	270
hard blue clay	270	360
fine water sand	360	370
hard water sand	370	380

WELL LOCATION:
 sec 25 T 7 N R 12 E
 S W
Pass Christian
 (distance) (direction) (nearest town)

WELL PURPOSE: home
 (home, irrigation, municipal, industrial)

- WELL COMPLETION DATA:
- diameter (inches) 2"
 - total depth (feet) 380
 - static water level (feet) 10 below above top of ground.
 - casing PVC, 370,
 (material) (depth)
 (size) if telescope see back.
 - screen 10, 370
 (length) (depth to top)
2", PVC
 (size) (material)
 - pump 1, 17-10
 (HP) (yield gpm)
ELC.
 (type power)
 - electric log No
 (yes or no)
 (organization running log)
 - how well bottom plugged 2" back
wash valve, 19-B


RECEIVED
 AUG - 2 1985

DRILLERS REMARKS:

Department of Natural Resources
 Bureau of Land & Water Resources

If well telescopes please sketch and show depths.

GROUND LEVEL

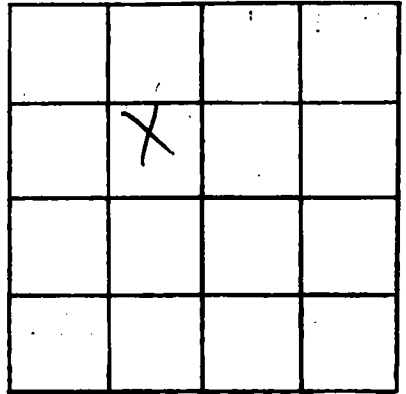

SECTION _____

Please indicate well location X.

ADDITIONAL INFORMATION

If more than one screen, show locations of each on sketch.