

Harrison
K 2020
5/22/85

MISSISSIPPI
BOARD OF WATER COMMISSIONERS
416 North State Street
Jackson, Mississippi 39201

WATER WELL DRILLERS LOG

5-22-85 19 Rid. Mooka HARRISON
date well completed firm name county well located

LANDOWNER: LADNER BROS
SAND + GRAVEL
Red Creek RD

Gulfport, MS 39503
(mailing address)

WELL LOCATION:
sec. 17 T-7 N R-12 E
6 miles N of Long Beach
(distance) (direction) (nearest town)

WELL PURPOSE: Office
(home, irrigation, municipal, industrial)

WELL COMPLETION DATA:

- (1) diameter (inches) 2"
- (2) total depth (feet) 560'
- (3) static water level (feet) 25' below above top of ground.
- (4) casing PVC 560'
(material) (depth)
 if telescope see back.
(size)
- (5) screen 10' 560'
(length) (depth to top)
2" PVC
(size) (material)
- (6) pump 1 10
(HP) (yield gpm)
E
(type power)
- (7) electric log
(yes or no)

(organization running log)
- (8) how well bottom plugged BW


description of formations encountered	from	to
Top Soil	0	10
River Sand & Gravel	10	50
Blue Clay	50	180
Fine SILTY Sand	180	200
Blue Clay	20	466
Fine SAND	460	480
med Sand	480	520
Coarse Sand	520	560

DRILLERS REMARKS:

RECEIVED
JUN - 1 1985

If well telescopes please sketch and show depths.

GROUND LEVEL

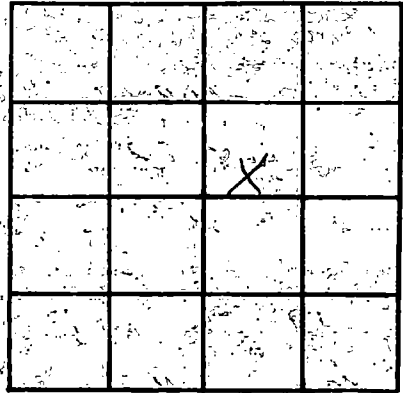

SECTION 10

Please indicate well location X.

ADDITIONAL INFORMATION

If more than one screen, show locations of each on sketch.