

MISSISSIPPI DEPARTMENT OF NATURAL RESOURCES

Bureau of Land and Water Resources

Southport Mall

P.O. Box 10631

Jackson, Mississippi 39209

WATER WELL DRILLERS LOG

Harrison
K 2021
5-28-85

5-28 1985 date well completed McMill Well Works firm name Harrison county well located

LANDOWNER: Ruth Simmons
P.O. Box 491
Long Beach, Ms. 39560
(mailing address)

WELL LOCATION:
sec. 28 T. 7 N. R. 12 E.
6 miles N of LB
(distance) (direction) (nearest town)

WELL PURPOSE:
(home, irrigation, municipal, industrial)

WELL COMPLETION DATA:

(1) diameter (inches) 2"

(2) total depth (feet) 440'

(3) static water level (feet) 40 below top of ground.

(4) casing 2 1/2" PVC 430'
(material) (depth)

_____ If telescope see back.
(size)

(5) screen 10', 430'
(length) (depth to top)

2" galv. lcl. sd
(size) (material)

(6) pump 1 9
(HP) (yield gpm)

ELECT
(type power)

(7) electric log _____
(yes or no)

_____ (organization running log)

(8) how well bottom plugged sdcl

| description of formations encountered | from | to |
|---------------------------------------|------|-----|
| Mud | 0 | 20 |
| Mud/Sand | 20 | 40 |
| Mud | 40 | 60 |
| Mud | 60 | 80 |
| Mud/Sand | 80 | 100 |
| Sand/Mud | 100 | 120 |
| Mud | 120 | 140 |
| Mud | 140 | 160 |
| Mud | 160 | 180 |
| Mud | 180 | 200 |
| Mud | 200 | 220 |
| Mud/Sand | 220 | 240 |
| Mud | 240 | 260 |
| Mud/Sand | 260 | 280 |
| Mud | 280 | 300 |
| Mud | 300 | 320 |
| Mud | 320 | 340 |
| Mud | 340 | 360 |
| Mud | 360 | 380 |
| Mud/Sand | 380 | 400 |
| Sand | 400 | 420 |


RECEIVED
JUN 11 1985

DRILLERS REMARKS:

Department of Natural Resources
Bureau of Land & Water Resources

If well telescopes please sketch and show depths.

GROUND LEVEL

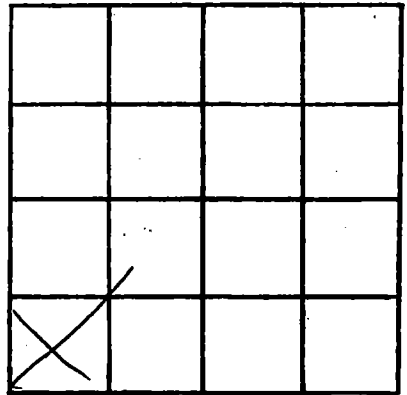

SECTION _____

Please indicate well location X.

ADDITIONAL INFORMATION

If more than one screen,
show locations of each on sketch.