

**MISSISSIPPI DEPARTMENT OF NATURAL RESOURCES**  
**Bureau of Land and Water Resources**  
 Southport Mall  
 P.O. Box 10631  
 Jackson, Mississippi 39209  
**WATER WELL DRILLERS LOG**

K 2024  
HARRISON  
7-26-85

7-26-85 19  
 date well completed

R. J. Mooker  
 firm name

HARRISON  
 county well located

LANDOWNER ROBINSON BONUS  
ROBINSON RD  
Osprey, MS  
 (mailing address)

WELL LOCATION:  
 sec. 2 T. 7 N. R. 12 E  
4 miles W of NEIGENT  
 (distance) (direction) (nearest town)

WELL PURPOSE:  
 (Home, Irrigation, municipal, industrial)

WELL COMPLETION DATA:

(1) diameter (inches) 4 x 2

(2) total depth (feet) 590'

(3) static water level (feet) 90' below above top of ground.

(4) casing Pvc, 590'  
 (material) (depth)  
 (size) if telescope see back.

(5) screen 20', 590'  
 (length) (depth to top)  
2", Pvc  
 (size) (material)

(6) pump 1, SUB  
 (HP) (yield gpm)  
E, 1992L  
 (type power)

(7) electric log yes or no  
 (organization running log)

(8) how well bottom plugged Raw blue


description of formations encountered	from	to
TOP SOIL	0	10
White Blue Clay	10	80
Blue Clay	80	300
Med Sand	300	340
Blue Clay	340	500
Med Sand	500	520
Med Sand	520	570
Coarse Sand	570	590

DRILLERS REMARKS:

**RECEIVED**  
 OCT 1 0 1985  
 Bureau of Natural Resources  
 Department of Land & Water Resources

If well telescopes please sketch and show depths.

GROUND LEVEL

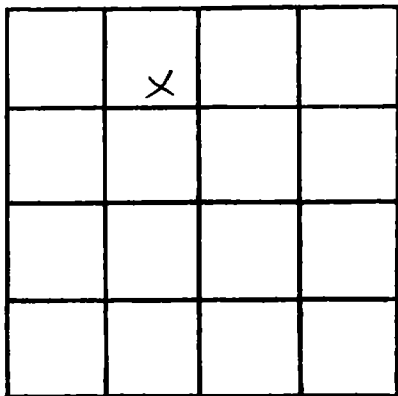

SECTION 2

Please indicate well location X.

ADDITIONAL INFORMATION

If more than one screen,  
show locations of each on sketch.