

MISSISSIPPI DEPARTMENT OF NATURAL RESOURCES

Bureau of Land and Water Resources

Southport Mall

P.O. Box 10631

Jackson, Mississippi 39209

WATER WELL DRILLERS LOG

HARRISON
K 2025
7-31

7-31 1985 McHill Pump & Well Harrison
date well completed firm name county well located

LANDOWNER: Doug Saucier
Rt. 2 Box 282
Pass Christian Ms.
(mailing address)

WELL LOCATION:
sec. 11 T 7 N R 12 E
5 miles S of Dedeaux
(distance) (direction) (nearest town)

WELL PURPOSE:
(home, irrigation, municipal, industrial)

- WELL COMPLETION DATA:
- (1) diameter (inches) 2"
 - (2) total depth (feet) 360'
 - (3) static water level (feet) 60' ^{below} top of ground
 - (4) casing 40 PVC 350'
(material) (depth)
 - (size) If telescope see back.
 - (5) screen 10' 350'
(length) (depth to top)
 - 2" 80 PVC - 6 slot
(size) (material)
 - (6) pump N/A
(HP) (yield gpm)
 - (type power)
 - (7) electric log
(yes or no)
 - (organization running log)
 - (8) how well bottom plugged Sand Seal

description of formations encountered	from	to
Mud / sand	0	20
sand / mud	20	40
Mud	40	160
Mud / sand	160	180
Sand / mud	180	200
Mud	200	260
Sand / mud	260	280
Mud	280	300
Mud / sand	300	340
Sand	340	360


RECEIVED
AUG 20 1985

Department of Natural Resources
Bureau of Land & Water Resources

DRILLERS REMARKS:

If well telescopes please sketch and show depths.

GROUND LEVEL

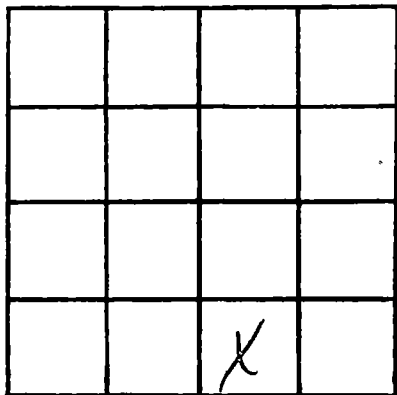

SECTION _____

Please indicate well location X.

ADDITIONAL INFORMATION

If more than one screen,
show locations of each on sketch.