

MISSISSIPPI DEPARTMENT OF NATURAL RESOURCES

Bureau of Land and Water Resources

Southport Mall

P.O. Box 10631

Jackson, Mississippi 39209

WATER WELL DRILLERS LOG

HARRISON
K 2026

7-25

date well completed

1985

McMill Pump & Well

firm name

Harrison

county well located

LANDOWNER: Tarver Byrd

description of formations encountered

from

to

Rt. 1 Box 1082

Southport, Ms. 39501
(mailing address)

Mud
Mud/Sand
Sand

0 220
220 240
240 250

WELL LOCATION:

sec. 35 T. 7 N. R. 12 E.
4 miles N of Long Beach
(distance) (direction) (nearest town)

WELL PURPOSE:

(home, irrigation, municipal, industrial)

WELL COMPLETION DATA:

- (1) diameter (inches) 2"
- (2) total depth (feet) 250'
- (3) static water level (feet) 40' below above top of ground.
- (4) casing Sch. 40 PVC, 240'
(material) (depth)
(size) If telescope see back.
- (5) screen 10', 240'
(length) (depth to top)
2", Sch. 80 galv PVC
(size) (material)
- (6) pump 1 (HP) 8 (yield gpm)
Flec.
(type power)
- (7) electric log
(yes or no)

(organization running log)

(8) how well bottom plugged SAND SEAL

RECEIVED


AUG 26 1985

DRILLERS REMARKS:

Department of Natural Resources
Bureau of Land & Water Resources

If well telescopes please sketch and show depths.

GROUND LEVEL

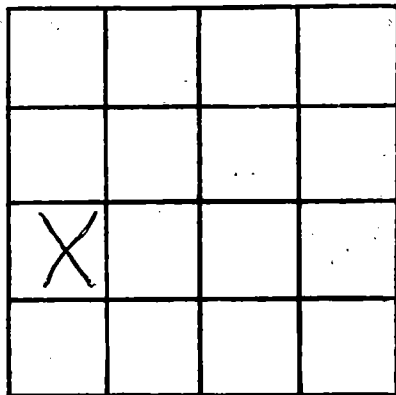

SECTION _____

Please indicate well location X.

ADDITIONAL INFORMATION

If more than one screen,
show locations of each on sketch.