

MISSISSIPPI DEPARTMENT OF NATURAL RESOURCES

Bureau of Land and Water Resources

Southport Mall

P.O. Box 10631

Jackson, Mississippi 39209

WATER WELL DRILLERS LOG

<u>Harrison</u>
<u>K</u>
<u>2028</u>

10-7 1985
date well completed

McMill Pumpwell
firm name

Harrison
county well located

LANDOWNER: F.V. Martin
Rt. 1 Box 317
Gulfport Ms. 39503
(mailing address)

WELL LOCATION:
sec. 13 T 7 N R 12 E
3 miles N of Gulfport
(distance) (direction) (nearest town)

WELL PURPOSE:
(home, irrigation, municipal, industrial)

WELL COMPLETION DATA:

(1) diameter (inches) 2"

(2) total depth (feet) 260'

(3) static water level (feet) 50' below above top of ground.

(4) casing Sch 40 PVC 250'
(material) (depth)
(size) if telescope see back.

(5) screen 10' 250'
(length) (depth to top)
2" Sch 80 PVC - 6 slot
(size) (material)

(6) pump N/A (MP) (yield gpm)
(type power)

(7) electric log _____
(yes or no)
(organization running log)

(8) how well bottom plugged SAND
SHARK

description of formations encountered	from	to
<u>Mud / sand</u>	<u>0</u>	<u>20</u>
<u>Sand / Gravel</u>	<u>20</u>	<u>40</u>
<u>Sand / Gravel / Mud</u>	<u>40</u>	<u>60</u>
<u>Mud</u>	<u>60</u>	<u>110</u>
<u>Sand</u>	<u>110</u>	<u>140</u>
<u>Mud</u>	<u>140</u>	<u>170</u>
<u>Sand</u>	<u>170</u>	<u>210</u>
<u>Mud</u>	<u>210</u>	<u>220</u>
<u>Sand</u>	<u>220</u>	<u>260</u>


RECEIVED
NOV 26 1985

Department of Natural Resources
Bureau of Land & Water Resources

DRILLERS REMARKS:

If well telescopes please sketch and show depths.

GROUND LEVEL

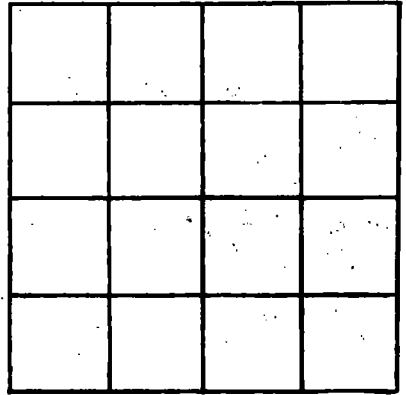

SECTION _____

Please indicate well location X.

ADDITIONAL INFORMATION

If more than one screen,
show locations of each on sketch.