

MISSISSIPPI DEPARTMENT OF NATURAL RESOURCES

Bureau of Land and Water Resources

Southport Mall

P.O. Box 10631

Jackson, Mississippi 39209

WATER WELL DRILLERS LOG

HARRISON
K
2029

10-12-85

19

Mc Hill Pump & Well

Harrison

date well completed

firm name

county well located

LANDOWNERS: Thomas Cunningham

description of formations encountered

from

to

PO Box 1883

Southport, Ms. 39502
(mailing address)

WELL LOCATION:

sec. 35 T 7 N R 12 E
4 miles W of Southport
(distance) (direction) (nearest town)

WELL PURPOSE:

(home, irrigation, municipal, industrial)

WELL COMPLETION DATA:

- (1) diameter (inches) 2"
- (2) total depth (feet) 460'
- (3) static water level (feet) 160' below top of ground.
- (4) casing: Sch 40 PVC, 450', (material) (depth)
- (size) if telescope see back.
- (5) screen 10', 450' (length) (depth to top)
- 2" Sch 80 PVC - 6 slot (size) (material)
- (6) pump 1 (HP) 7 (yield gpm)
- Edcc. (type power)
- (7) electric log (yes or no)

(organization running log)

(8) how well bottom plugged sand STARK

DRILLERS REMARKS:


RECEIVED

NOV 26 1985

Department of Natural Resources
Bureau of Land & Water Resources

If well telescopes please sketch and show depths.

GROUND LEVEL

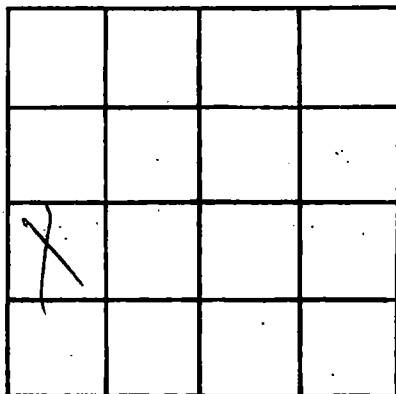

SECTION _____

Please indicate well location X.

ADDITIONAL INFORMATION

If more than one screen, show locations of each on sketch.