

MISSISSIPPI DEPARTMENT OF NATURAL RESOURCES

Bureau of Land and Water Resources

Southport Mall

P.O. Box 10631

Jackson, Mississippi 39209

WATER WELL DRILLERS LOG

HARRISON  
K  
2030

Feb. 8 1986 M. Earl King's Well Harrison  
date well completed firm name county well located

LANDOWNER: Bruce Walker  
847 Peninsular Rd.  
L.A., Miss.  
(mailing address)

description of formations encountered	from	to
<u>Sand</u>	<u>0</u>	<u>40</u>
<u>clay - mud</u>	<u>41</u>	<u>80</u>
<u>mud</u>	<u>80</u>	<u>116</u>
<u>Sand-mud</u>	<u>116</u>	<u>207</u>
<u>Sand</u>	<u>300</u>	<u>407</u>
<u>C. Sand.</u>	<u>400</u>	<u>440</u>

WELL LOCATION:  
sec. 33 T ? N R 12 E  
(S) (W)  
10 miles (W) of Hot  
(distance) (direction) (nearest town)

WELL PURPOSE:  
(home, irrigation, municipal, industrial)

- WELL COMPLETION DATA:
- (1) diameter (inches) 2"
  - (2) total depth (feet) 440'
  - (3) static water level (feet) \_\_\_\_\_ below/above top of ground.
  - (4) casing Sch. 110 " 430'  
(material) (depth)
  - \_\_\_\_\_ (size) if telescope see back.
  - (5) screen 10' (length) \_\_\_\_\_ (depth to top)  
2" (size) Sch. 80 (material)
  - (6) pump 1 (HP) 4 (yield gpm)  
electric (type power)
  - (7) electric log / (yes or no)  
(organization running log)
  - (8) how well bottom plugged Sand Seal.


**RECEIVED**  
MAR 6 - 1986

Department of Natural Resources  
Bureau of Land & Water Resources

DRILLERS REMARKS:

If well telescopes please sketch and show depths.

GROUND LEVEL

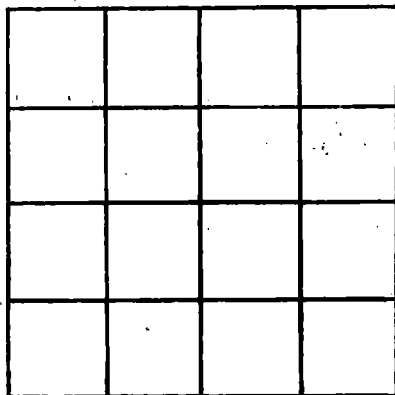

SECTION \_\_\_\_\_

Please indicate well location X.

ADDITIONAL INFORMATION

If more than one screen, show locations of each on sketch.