

MISSISSIPPI DEPARTMENT OF NATURAL RESOURCES

Bureau of Land and Water Resources

Southport Mall

P.O. Box 10631

Jackson, Mississippi 39209

WATER WELL DRILLERS LOG

HARRISON
K
2032

date well completed

197-12-85 Greenwell

firm name

Abbeville county well located

LANDOWNER:

Greenwell, Bruce

description of formations encountered

from

to

Rt. 2, Box 120-A

Pass Christian, MS 39571
(mailing address)

white clay	0	40
blue clay blue clay	110	250
SAND	250	260
blue clay	260	340
SAND	340	360

WELL LOCATION:

sec 14 T 7 N R 12 E
4 miles W of Langford
(distance) (direction) (nearest town)

WELL PURPOSE:

(home, irrigation, municipal, industrial)

home

WELL COMPLETION DATA:

- (1) diameter (inches) 4x2
- (2) total depth (feet) 360
- (3) static water level (feet) 45 ^{below} ~~above~~ top of ground.
- (4) casing plastic (material), 360 (depth)
- 4x2 (size) if telescope see back.
- (5) screen 20 feet (length), 340 (depth to top)
- 4x2 (size), plastic (material)
- (6) pump 1 (HP), 23 (yield gpm)
- electric (type power)
- (7) electric log no (yes or no)
- no (organization running log)
- (8) how well bottom plugged SAND
SHARK



RECEIVED
APR 9 1986

DRILLERS REMARKS:

Department of Natural Resources
Bureau of Land & Water Resources

If well telescopes please sketch and show depths.

GROUND LEVEL

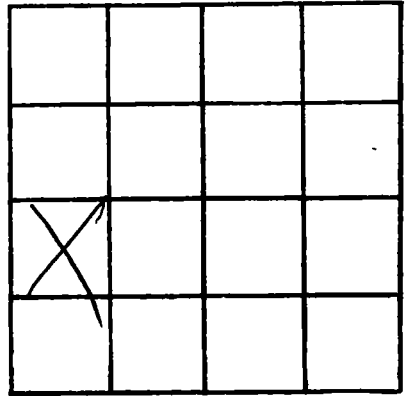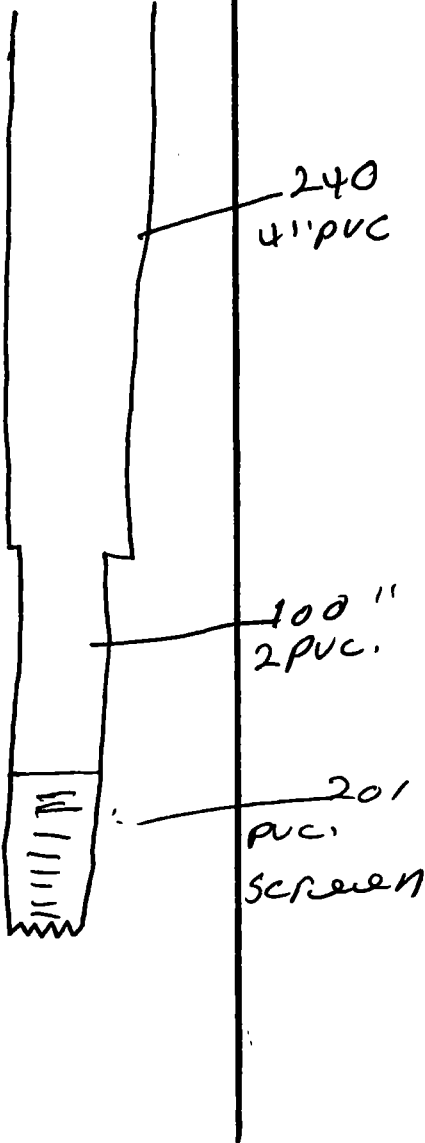

SECTION _____

Please indicate well location X.

ADDITIONAL INFORMATION

If more than one screen, show locations of each on sketch.