

MISSISSIPPI DEPARTMENT OF NATURAL RESOURCES

Bureau of Land and Water Resources

Southport Mall

P.O. Box 10631

Jackson, Mississippi 39209

WATER WELL DRILLERS LOG

JACKSON  
K  
2036

May 7 1986 Mc Gill Abbeville  
 date well completed firm name county well located

LANDOWNERS Gene Robertson  
 (mailing address)

description of formations encountered	from	to
<u>2' Sand</u>	<u>0</u>	<u>40</u>
<u>mu? Sand</u>	<u>40</u>	<u>280</u>
<u>Sand</u>	<u>280</u>	<u>300</u>
<u>mu? Sand</u>	<u>300</u>	<u>310</u>
<u>Sand</u>	<u>310</u>	<u>3110</u>

WELL LOCATION:  
 sec. 14 T. 2 N. R. 12 E  
2 miles West of Sources  
 (distance) (direction) (nearest town)

WELL PURPOSE: Home  
 (home, irrigation, municipal, industrial)

WELL COMPLETION DATA:

(1) diameter (inches) 2"

(2) total depth (feet) \_\_\_\_\_

(3) static water level (feet) 340 <sup>below</sup> <sub>above</sub> top of ground

(4) casing Pvc, 330;  
 (material) (depth)  
2" If telescope see back.  
 (size)

(5) screen 10', Bottom  
 (length) (depth to top)  
2", Pvc  
 (size) (material)

(6) pump 8 (HP) \_\_\_\_\_ (yield gpm)  
 (type power)

(7) electric log No  
 (yes or no)  
 (organization running log)

(8) how well bottom plugged Sand

**RECEIVED**


AUG 7 1986

Department of Natural Resources  
 Bureau of Land & Water Resources

DRILLERS REMARKS: \_\_\_\_\_

Well telescopes please  
sketch and show depths.

GROUND LEVEL

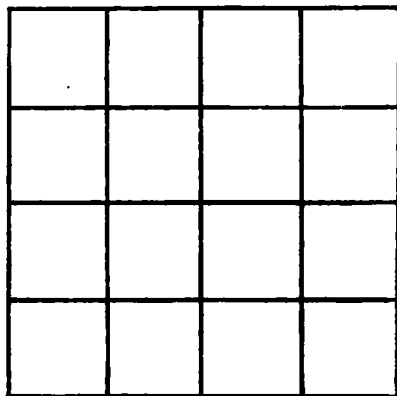

SECTION \_\_\_\_\_

Please indicate well location X.

ADDITIONAL INFORMATION

If more than one screen,  
show locations of each on sketch.