

MISSISSIPPI DEPARTMENT OF NATURAL RESOURCES

Bureau of Land and Water Resources

Southport Mall

P.O. Box 10631

Jackson, Mississippi 39209

WATER WELL DRILLERS LOG

HARRISON
K
2037

31 May 81 19 McGill Pump Wells Harrison
date well completed firm name county well located

LANDOWNER: Earl Stegall
P.O. Box 1542
Gulfport Mo.
(mailing address)

description of formations encountered	from	to
<u>Mud</u>	<u>0</u>	<u>160</u>
<u>Sand</u>	<u>160</u>	<u>190</u>
<u>mud</u>	<u>190</u>	<u>320</u>
<u>Sand</u>	<u>320</u>	<u>330</u>
<u>mud</u>	<u>320</u>	<u>460</u>
<u>Sand</u>	<u>460</u>	<u>510</u>
<u>mud</u>	<u>510</u>	<u>525</u>
<u>Sand</u>	<u>525</u>	<u>530</u>

WELL LOCATION:
sec 4 T 2 N R 12 E 28
5 miles North of I-10 Exit 8
(distance) (direction) (nearest town)

WELL PURPOSE: home
(home, irrigation, municipal, industrial)

WELL COMPLETION DATA:

(1) diameter (inches) 2"

(2) total depth (feet) 530'

(3) static water level (feet) 95' below above top of ground.


(4) casing PVC 530
(material) (depth)
2" if telescope see back.
(size)

(5) screen 10' Bottom
(length) (depth to top)
2" PVC
(size) (material)

(6) pump 1 7
(HP) (yield gpm)
electric
(type power)

(7) electric log No
(yes or no)
(organization running log)

(8) how well bottom plugged Seal

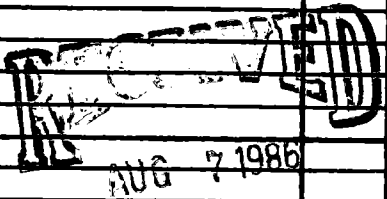


Department of Natural Resources
Bureau of Land & Water Resources

DRILLERS REMARKS:

If well telescopes please sketch and show depths.

GROUND LEVEL

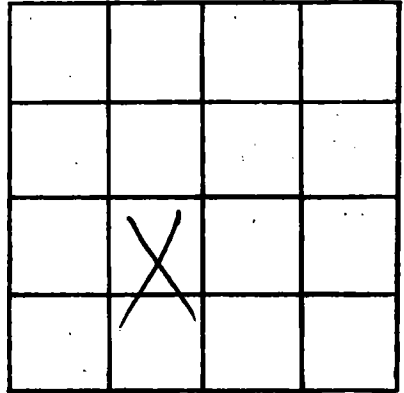

SECTION _____

Please indicate well location X.

ADDITIONAL INFORMATION

If more than one screen, show locations of each on sketch.