

MISSISSIPPI DEPARTMENT OF NATURAL RESOURCES

Bureau of Land and Water Resources

Southport Mall

P.O. Box 10631

Jackson, Mississippi 39209

WATER WELL DRILLERS LOG

HARRISON
K
7040

Aug 4 1986 McMill Pump Well & Harrison
date well completed firm name county well located

LANDOWNER: <u>Donny Poyette</u>	description of formations encountered	from	to
(mailing address)	<u>Sand</u>	<u>0</u>	<u>30</u>
WELL LOCATION:	<u>mud</u>	<u>30</u>	<u>210</u>
sec. <u>35</u> T. <u>2</u> N. R. <u>12</u> E	<u>SAND</u>	<u>210</u>	<u>250</u>
<u>5</u> miles <u>West</u> of <u>Buff Out</u> (distance) (direction) (nearest town)	<u>mud</u>	<u>250</u>	<u>400</u>
WELL PURPOSE: <u>Home</u> (home, irrigation, municipal, industrial)	<u>Sand</u>	<u>400</u>	<u>440</u>
WELL COMPLETION DATA:			
(1) diameter (inches) <u>4" x 2"</u>			
(2) total depth (feet) <u>440</u>			
(3) static water level (feet) <u>30</u> <u>below</u> top of ground <u>above</u>			
(4) casing <u>PVC</u> <u>420</u> (material) (depth)			
<u>4x2</u> If telescope see back. (size)			
(5) screen <u>20'</u> <u>Bottom</u> (length) (depth to top)			
<u>2"</u> <u>PVC</u> (size) (material)			
(6) pump <u>1/2</u> <u>18</u> (HP) (yield gpm)			
<u>Electric</u> (type power)			
(7) electric log <u>no</u> (yes or no)			
(organization running log)			
(8) how well bottom plugged <u>Seal</u>			
DRILLERS REMARKS:			

RECEIVED

AUG 26 1986


Department of Natural Resources
Bureau of Land & Water Resources

If well telescopes please sketch and show depths.

GROUND LEVEL

120'-4" TOP

320'-2" Bottom

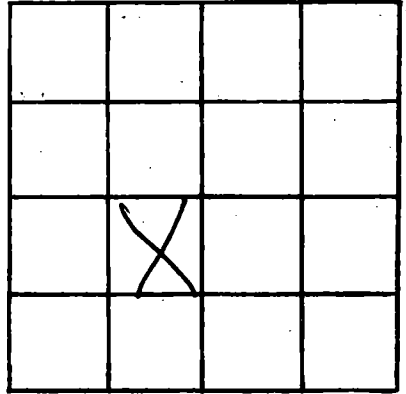

SECTION _____

Please indicate well location X.

ADDITIONAL INFORMATION

If more than one screen, show locations of each on sketch.