

MISSISSIPPI DEPARTMENT OF NATURAL RESOURCES

Bureau of Land and Water Resources

Southport Mall

P.O. Box 10631

Jackson, Mississippi 39209

WATER WELL DRILLERS LOG

Harrison
K
2041

Aug 16 - 86 19 McMill Pump & Wells Harrison
 date well completed firm name county well located


LANDOWNER: Baura Norton
Thompson rd
Shuffport Ms.
 (mailing address)

description of formations encountered	from	to
<u>mud</u>	<u>0</u>	<u>50</u>
<u>sand</u>	<u>50</u>	<u>90</u>
<u>mud</u>	<u>90</u>	<u>190</u>
<u>sand</u>	<u>190</u>	<u>230</u>
<u>mud</u>	<u>230</u>	<u>470</u>
<u>sand</u>	<u>470</u>	<u>500</u>
<u>mud</u>	<u>500</u>	<u>600</u>
<u>sand</u>	<u>600</u>	<u>640</u>

WELL LOCATION:
 sec. 21 T 7 N R 12 E
4 miles 4 1/2 W of Shuffport
 (distance) (direction) (nearest town)

WELL PURPOSE: Home
 (home, irrigation, municipal, industrial)

- WELL COMPLETION DATA:
- (1) diameter (inches) 4" x 2"
 - (2) total depth (feet) 640'
 - (3) static water level (feet) 30' ^{below}/_{above} top of ground
 - (4) casing PVC 620'
 (material) (depth)
4" x 2" If telescope see back.
 (size)
 - (5) screen 20' Balton
 (length) (depth to top)
2" PVC
 (size) (material)
 - (6) pump 1 sub 20
 (HP) (yield gpm)
electric
 (type power)
 - (7) electric log No
 (yes or no)
 (organization running log)
 - (8) how well bottom plugged Seal

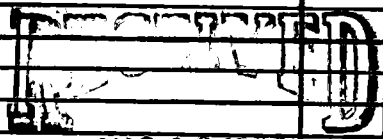

AUG 26 1986

Department of Natural Resources
 Bureau of Land & Water Resources


DRILLERS REMARKS:

If well telescopes please sketch and show depths.

GROUND LEVEL

120'-4" Top

520'-12" bottom

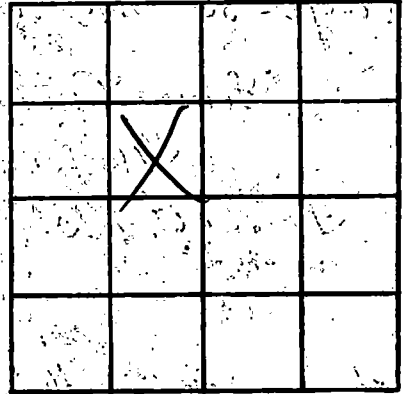

SECTION _____

Please indicate well location-X.

ADDITIONAL INFORMATION

Multiple horizontal lines for additional information.

If more than one screen, show locations of each on sketch.