

MISSISSIPPI DEPARTMENT OF NATURAL RESOURCES

Bureau of Land and Water Resources

Southport Mall

P.O. Box 10631

Jackson, Mississippi 39209

WATER WELL DRILLERS LOG

HARRISON  
K  
2042

Aug 13

19

Sub McMill Pump & Well

firm name

Harrison

county well located

LANDOWNER: Jason & Teanna

description of formations encountered

from

to

P.O. Box 294

Sand / gravel

0 140

San Christian St.

Mud

140 240

(mailing address)

Sand

240 310

WELL LOCATION:

Mud

310 430

sec. 8 T. 2 N. R. 12 E.  
1 miles South of White  
(distance) (direction) (nearest town)

Sand

430 540

WELL PURPOSE: Home  
(home, irrigation, municipal, industrial)

WELL COMPLETION DATA:

- (1) diameter (inches) 2"
- (2) total depth (feet) 540'
- (3) static water level (feet) 4' below top of ground above
- (4) casing PVC, 530',  
(material) (depth)  
2" if telescope see back.  
(size)
- (5) screen 10', Bottom  
(length) (depth to top)  
2", PVC  
(size) (material)
- (6) pump 1 (HP) 11 (yield gpm)  
Electric  
(type power)
- (7) electric log No  
(yes or no)  
(organization running log)
- (8) how well bottom plugged Seal

RECEIVED


AUG 26 1986

DRILLERS REMARKS:

Department of Natural Resources  
Bureau of Land & Water Resources

If well telescopes please sketch and show depths.

GROUND LEVEL

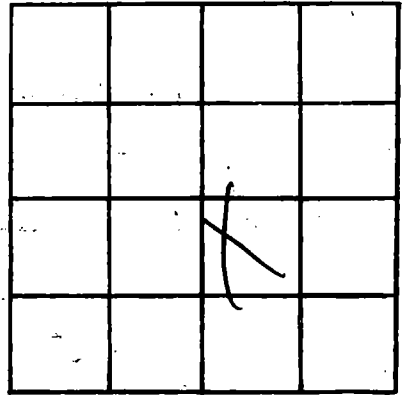

SECTION \_\_\_\_\_

Please indicate well location X.

ADDITIONAL INFORMATION

If more than one screen, show locations of each on sketch.