

762-1561 997-3084  
**MISSISSIPPI DEPARTMENT OF NATURAL RESOURCES**  
 Bureau of Land and Water Resources

P.O. Box 10631  
 Jackson, Mississippi 39209  
**WATER WELL DRILLERS LOG**

COUNTY WELL LOCATED <b>Harrison</b>	
WELL NUMBER <b>K</b>	CODED
<b>2047</b>	
DATE WELL COMPLETED <b>9-1-86</b>	

PERMIT NUMBER
NAME OF DRILLING FIRM <b>Coast Water Well</b>

NAME & MAILING ADDRESS OF LANDOWNER <b>Durell Husley</b>		
<b>Landon Rd</b>		
<b>Gulfport, MS 39501</b>		
WELL LOCATION: SEC	TOWNSHIP	RANGE
<b>13</b>	<b>7</b>	<b>N 12 E</b>
DISTANCE	DIRECTION	NEAREST TOWN
<b>2</b> Miles	<b>NW</b>	<b>Gulf Port</b>
OTHER LANDMARK		
WELL PURPOSE: Home, Irrigation, Municipal, Industrial, Fish Pond, etc. <b>home</b>		

<b>PUMP DATA</b>		
PUMP TYPE (Circle One): Submersible, Turbine, <b>Flowing Well</b> , Other (Describe)		
POWER TYPE (Circle One): <b>Electric</b> , Tractor, Diesel, Gasoline, Butane, Other (Describe)		
Pump Capacity (GPM) <b>9</b>	No. of Stages <b>2</b>	Setting Depth <b>FT.</b>
PUMP TEST		
Well yielded _____ GPM with a drawdown of _____ ft. after _____ hours of pumping		

<b>WELL DATA</b>		
Well Depth <b>450'</b>	Casing Diameter (In.) <b>2"</b>	Casing Length (Ft.) <b>425'</b>
Type of Casing <b>PVC</b>	Hole Depth <b>450'</b>	Depth to Static Water Level <b>35'</b>
TYPE OF COMPLETION: (Circle One or More): <b>Natural Development</b> , Gravel Packed, Underreamed, Telescoped, Open Hole, Other (Describe)		
Top of Lap Pipe or Reduction in Casing		
FEET	IF TELESCOPED OR MORE THAN ONE SCREEN: USE BACK PAGE	

<b>LOG DATA</b>	
TYPE OF LOG RUN (Circle One): Electric, Gamma Ray, Density, Sonic, <b>No Log Run</b> , Neutron, Other (Describe)	
Name of Organization Running Log _____	


<b>SCREEN DATA</b>		
Diameter - Inches <b>2"</b>	Length - Feet <b>20'</b>	Slot Size - Inches <b>10' = 1000</b> <b>18' = 2000</b>
Screen Type <b>PVC</b>	Depth to Bottom - Feet <b>445'</b>	

<b>GEOLOGIC DATA (Office Use Only)</b>			
Surface Elev.	Geologic Unit	Unit Thickness	Depth to Top
Subs. SWL	Date	Analysis	Aquifer Test

Driller's Remarks


DESCRIPTION OF FORMATIONS ENCOUNTERED	FROM	TO	FORMATION (Continued)	FROM	TO
Top Soil	0	1	Gray coarse sand	155	195
Red Clay	1	11	Red Med Sand	195	230
Blue Clay	11	18	Blue Clay	230	382
Red coarse Sand	18	40	Gray Fine Sand	382	410
Blue Clay	40	105	Gray Med Sand	410	428
Blue Clay + Clam Shell	105	155	over		

IF MORE SPACE IS NEEDED, USE BACK

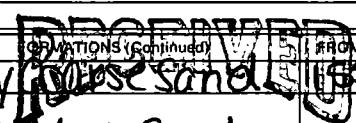

If well telescopes please sketch and show depths.

GROUND LEVEL

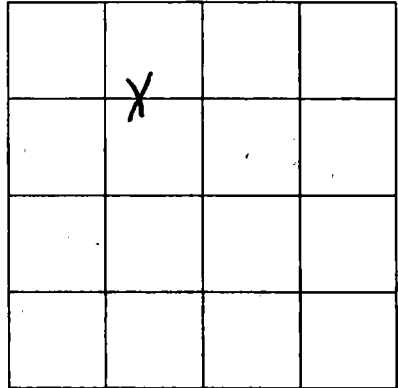

SECTION 13

Please indicate well location X:

ADDITIONAL INFORMATION

428-445 Gray Course Sand  
445-450 Blue Clay

If more than one screen,  
show location of each on sketch.