

Harrison
K 2057

MISSISSIPPI
BOARD OF WATER COMMISSIONERS
416 North State Street
Jackson, Mississippi 39201

WATER WELL DRILLERS LOG

3-5-87 19
date well completed

T.C.V. Mink
firm name

HARRISON
county well located

LANDOWNER: James E. Laird
165222
Shiloh RD Lyman

description of formations encountered

from to

Cadiz, MS

(mailing address)

WELL LOCATION:

sec. 14 T 11 N R 12 E
4 miles W of Lyman
(distance) (direction) (nearest town)

WELL PURPOSE:

(home, irrigation, municipal, industrial)

WELL COMPLETION DATA:

- diameter (inches) 2"
- total depth (feet) 540
- static water level (feet) 100 ^{below} _{above} top of ground.
- casing PVC, 540 (depth)
(material) (depth)

If telescope see back.
(size)

- screen 10, 540 (length) (depth to top)

2", PVC (size) (material)

- pump 1 1/2 HP, 5 (yield gpm)

E (type power)

- electric log (yes or no)

(organization running log)

- how well bottom plugged P.W. Mink

DRILLERS REMARKS:


RECEIVED

APR 08 1987

Department of Natural Resources
Bureau of Land & Water Resources

If well telescopes please sketch and show depths.

GROUND LEVEL

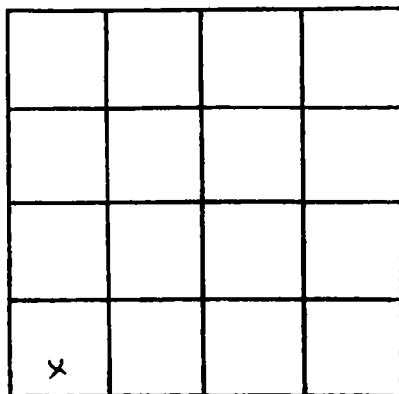

SECTION 11

Please indicate well location X.

ADDITIONAL INFORMATION

If more than one screen, show locations of each on sketch.