

# MISSISSIPPI DEPARTMENT OF NATURAL RESOURCES

Bureau of Land and Water Resources

COUNTY WELL LOCATED <u>Harrison</u>	
WELL NUMBER <u>K</u>	CODED
<u>2061</u>	
DATE WELL COMPLETED <u>MARCH 31-87</u>	

PERMIT NUMBER <u>0239</u>
NAME OF DRILLING FIRM <u>MC GILL PUMP &amp; WELLS</u>
<u>RT1 BOX 1643 CANAL RD</u>
<u>GUPT, MS 39503</u>

P.O. Box 10631  
Jackson, Mississippi 39209  
WATER WELL DRILLERS LOG

NAME & MAILING ADDRESS OF LANDOWNER <u>Richy Williams</u>			
<u>Nap Rd</u>			
<u>Long Beach, Ms.</u>			
WELL LOCATION	SEC	TOWNSHIP	RANGE
	<u>31</u>	<u>7 N</u>	<u>12 E</u>
DISTANCE	DIRECTION	NEAREST TOWN	
<u>5</u> Miles	<u>N/W</u>	of <u>Long Beach</u>	
OTHER LANDMARK			
WELL PURPOSE: <u>Home</u> Irrigation, Municipal, Industrial, Fish Pond, etc.			


PUMP DATA		
PUMP TYPE (Circle One): Submersible, Turbine, <u>Jet</u> Flowing Well, Other (Describe) _____		
POWER TYPE (Circle One): <u>Electric</u> Tractor, Diesel, Gasoline, Butane, Other (Describe) _____		
Pump Capacity (GPM) <u>10</u>	No. of Stages <u>2</u>	Setting Depth <u>80'</u> FT.
PUMP TEST		
Well yielded <u>10</u> GPM with a drawdown of <u>5</u> ft. after <u>1</u> hours of pumping		

WELL DATA		
Well Depth <u>500'</u>	Casing Diameter (In.) <u>2"</u>	Casing Length (Ft.) <u>20'</u>
Type of Casing <u>PVC</u>	Hole Depth <u>500'</u>	Depth to Static Water Level <u>480'</u>
TYPE OF COMPLETION: (Circle One or More): Gravel Packed, Underreamed, Telescoped, <u>Natural Development</u> , Open Hole, Other (Describe) _____		
Top of Lap Pipe or Reduction in Casing		
FEET	IF TELESKOPED OR MORE THAN ONE SCREEN: USE BACK PAGE	

LOG DATA	
TYPE OF LOG RUN (Circle One): <u>Electric</u> , Gamma Ray, Density, Sonic, <u>No Log Run</u> , Other (Describe) _____	
Name of Organization Running Log	


SCREEN DATA		
Diameter - Inches <u>2"</u>	Length - Feet <u>10'</u>	Slot Size - Inches <u>6</u>
Screen Type <u>sch 80 PVC</u>	Depth to Bottom - Feet <u>440'</u>	

GEOLOGIC DATA (Office Use Only)			
Surface Elev.	Geologic Unit	Unit Thickness	Depth to Top
Subs. SWL	Date	Analysis	Aquifer Test
Driller's Remarks			

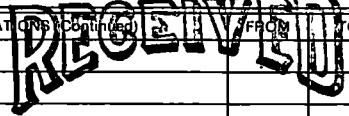DESCRIPTION OF FORMATIONS ENCOUNTERED	FROM	TO	FORMAT (ONE CONTINUED FROM)
<u>mud</u>	<u>0</u>	<u>10</u>	<div style="text-align: center;">   MAY 27 1987  Department of Natural Resources  Bureau of Land &amp; Water Resources </div>
<u>sand</u>	<u>10</u>	<u>80</u>	
<u>mud</u>	<u>80</u>	<u>160</u>	
<u>sand</u>	<u>160</u>	<u>200</u>	
<u>mud</u>	<u>200</u>	<u>460</u>	
<u>sand</u>	<u>460</u>	<u>500</u>	
IF MORE SPACE IS NEEDED, USE BACK			

If well telescopes please  
sketch and show depths.

GROUND LEVEL

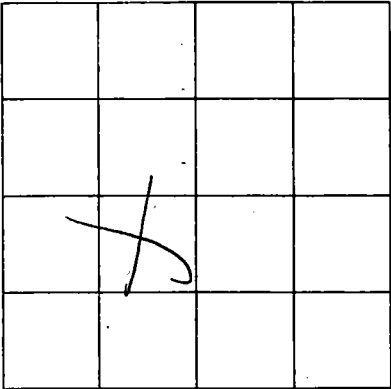

SECTION \_\_\_\_\_

Please indicate well location X.

ADDITIONAL INFORMATION

If more than one screen,  
show location of each on sketch.