

MISSISSIPPI DEPARTMENT OF NATURAL RESOURCES
Bureau of Land and Water Resources

P.O. Box 10631
Jackson, Mississippi 39209
WATER WELL DRILLERS LOG

COUNTY WELL LOCATED <i>Jackson</i>	
WELL NUMBER <i>K 2062</i>	CODED
DATE WELL COMPLETED <i>July 2-87</i>	

PERMIT NUMBER <i>0-239</i>
NAME OF WELL <i>RT1 BOX 1643 CANAL RD</i>
<i>GUPT, MS 39503</i>

NAME & MAILING ADDRESS OF LANDOWNER <i>Charles Hadauby</i>		
WELL LOCATION: SEC <i>9</i> TOWNSHIP <i>7</i> RANGE <i>12</i>		
DISTANCE <i>3</i> Miles	DIRECTION <i>North</i>	NEAREST TOWN <i>J10</i>
OTHER LANDMARK <i>County Farm Road</i>		
WELL PURPOSE: (Home Irrigation, Municipal, Industrial, Fish Pond, etc.)		

PUMP DATA		
PUMP TYPE (Circle One): <input checked="" type="radio"/> Submersible Turbine Jet Flowing Well, Other (Describe) _____		
POWER TYPE (Circle One): <input checked="" type="radio"/> Electric Tractor Diesel Gasoline Butane, Other (Describe) _____		
Pump Capacity (GPM) <i>18</i>	No. of Stages	Setting Depth <i>105'</i> FT.
PUMP TEST Well yielded <i>18</i> GPM with a drawdown of <i>20'</i> ft. after <i>1</i> hours of pumping		

WELL DATA		
Well Depth <i>540'</i>	Casing Diameter (In.) <i>4" x 2"</i>	Casing Length (Ft.) <i>540'</i>
Type of Casing <i>PVC</i>	Hole Depth <i>540'</i>	Depth to Static Water Level <i>60'</i>
TYPE OF COMPLETION: (Circle One or More): <input checked="" type="checkbox"/> Gravel Packed, <input type="checkbox"/> Underreamed, <input type="checkbox"/> Telescoped, <input checked="" type="checkbox"/> Natural Development <input type="checkbox"/> Open Hole, <input type="checkbox"/> Other (Describe) _____		
Top of Lap Pipe or Reduction in Casing FEET IF TELESCOPED OR MORE THAN ONE SCREEN: USE BACK PAGE		

LOG DATA	
TYPE OF LOG RUN (Circle One): <input checked="" type="radio"/> No Log Run, Electric, Gamma Ray, Density, Sonic, Neutron, Other (Describe) _____	
Name of Organization Running Log	

SCREEN DATA		
Diameter - Inches <i>2"</i>	Length - Feet <i>20'</i>	Slot Size - Inches <i>6ths</i>
Screen Type <i>PVC</i>	Depth to Bottom - Feet <i>540'</i>	

GEOLOGIC DATA (Office Use Only)			
Surface Elev.	Geologic Unit	Unit Thickness	Depth to Top
Subs. SWL	Date	Analysis	Aquifer Test

Driller's Remarks

DESCRIPTION OF FORMATIONS ENCOUNTERED	FROM	TO	FORMATIONS ENCOUNTERED	FROM	TO
<i>mud</i>	<i>0</i>	<i>10</i>	RECEIVED <i>JUL 24 1987</i> Department of Natural Resources Bureau of Land & Water Resources		
<i>sand</i>	<i>10</i>	<i>120</i>			
<i>mud</i>	<i>120</i>	<i>240</i>			
<i>sand</i>	<i>240</i>	<i>250</i>			
<i>mud</i>	<i>250</i>	<i>420</i>			
<i>sand</i>	<i>420</i>	<i>440</i>			
<i>mud</i>	<i>440</i>	<i>490</i>			
<i>sand</i>	<i>490</i>	<i>540</i>			


IF MORE SPACE IS NEEDED, USE BACK

If well telescopes please
sketch and show depths.

GROUND LEVEL

300'-4" TOP

340'-3" BOTTOM

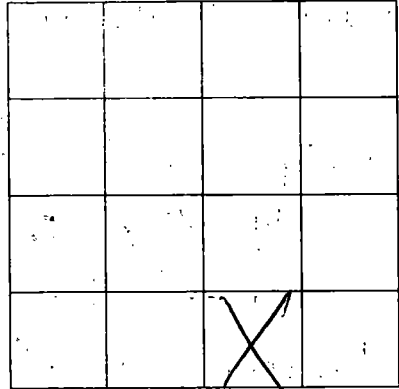

SECTION _____

Please indicate well location X.

ADDITIONAL INFORMATION

Lined area for additional information.

If more than one screen,
show location of each on sketch.